


Section 5 Township ~~34~~ 35 Range 2E
Well No. #1 Dyal
Company Harold Martin

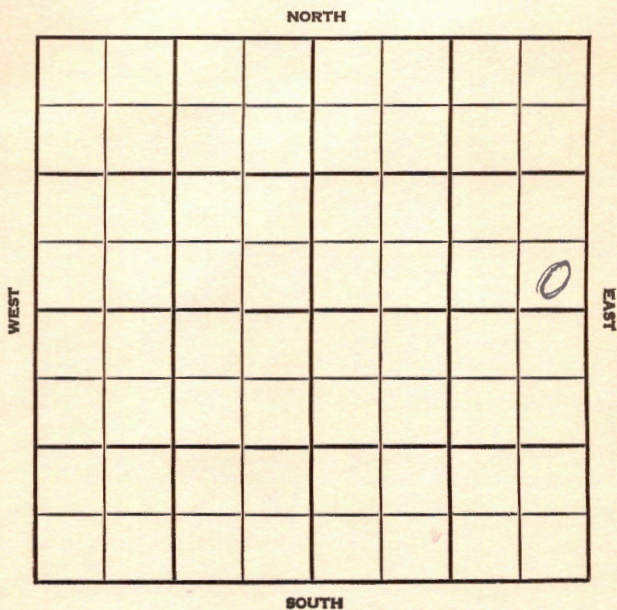

CORRECTION

FORM 513 SUNRAY

County Summer Elev. 2E
 Sec. 5 Twp. 35 31 Rge. 2E
 Company Harold Martin
 Farm Name Dyal No. 1

TOPS	DEPTH	LOG	DATUM	Loc. in Sec.
Anh.				SE SE NE
Tr.				
H.				
Tr.				
Dg.				
Bl.				
L.				Geol.
N.C.				Contr.
B.K.C.				Co. tools
Ce.				Pool
C.				Wildcat
M.				
M.				
K.				
Mz.				
Me.				
V.				
S.				
S.				
A.				
R.				
PE.				
G.				
T.D.				

ABANDONED
 FEB 13 '57

Date Comm. NOV 7 '56 NOV 13 '56 NOV 21 '56
NOV 28 '56 DEC 3 '56 DEC 12 '56 DEC 19 '56
DEC 26 '56 JAN 2 '57 JAN 9 '57 JAN 15 '57
JAN 28 '57 JAN 30 '57 FEB 6 '57 Loc. FEB 13 '57

Abd Laco

