


Section 5 Township 35 Range 2EWell No. #1 McClasky "B"Company Cappit Drlg.

NORTH

WEST

EAST

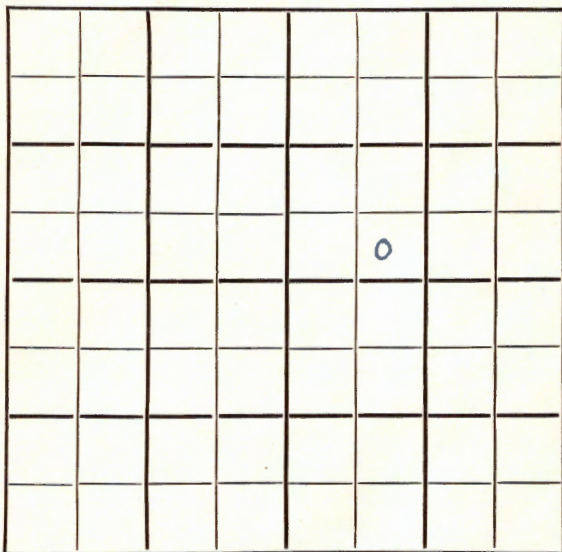

SOUTH

KANSAS

5

35

2E

#1 McClasky "B"

Cappit Drlg.

Dyal Pool

Ft. from N. Line

330

Ft. from S. Line

Ft. from E. Line

990

Ft. from W. Line

WEST

EAST

SOUTH

SE SW NE

1954

1158:

REPORT

2/3

Rng. Surface.

2/24

Spud 2-2-54


8th @ 110'

Stal. 2355', Cleveland 3102'

TD 3147'

D & A

ABANDONED

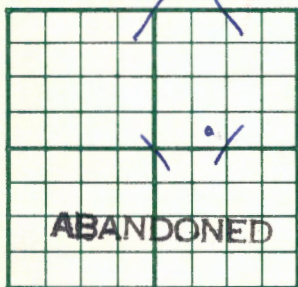County Sumner State KansasSec. 5 (Blk.
Twp.) 35 (Sur.
Rge.) 2E Map No.Operator Cappit Drlg.Well No. 1 Farm McClasky "B"Elev. 1158 Location SE SW NE330 Ft. From S Line NE990 Ft. From W Line Quarter

1st. Report

Completion FEB 24 1954Remarks Dyal PoolSpudding Date 2-2-54

Drlg. Data

8" @ 110 Stal. 2355 Cleveland 3102TD 3147D & A