


Section 4 Township 35 Range 2E

Well No. 3 Dyal

Company Bowman & Grissmore

NORTH

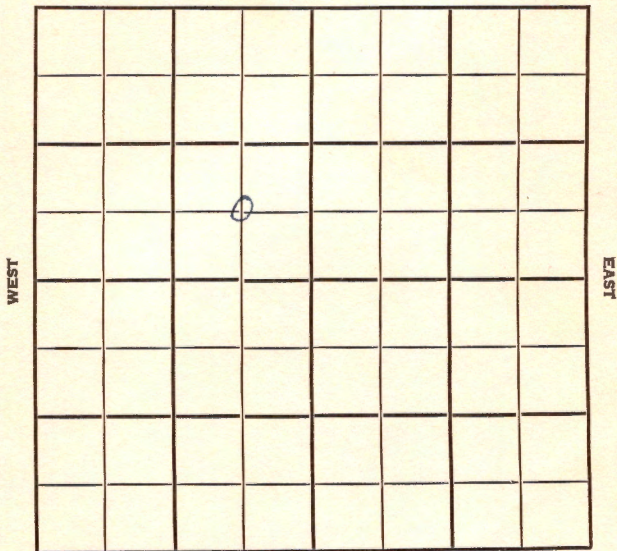

SOUTH

Summer

KANSAS

SEC. 4	TWP. 35	R. 2E
-----------	------------	----------

WELL NO. #3 Dyal FARM

COMPANY Bowman & Grissmore

CONTRACTOR Springer & Harper


Dyal

\_\_\_\_\_ Ft. from N. Line

\_\_\_\_\_ Ft. from S. Line

\_\_\_\_\_ Ft. from E. Line

\_\_\_\_\_ Ft. from W. Line

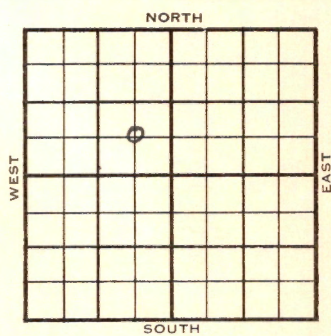

C SE NW

FIRST REPORT

1955	ELEVATION 1180'	REPORT
------	--------------------	--------

7/18 MIR

8-17 8 5/8" @ 134.100 5 1/2" @ 3166 60/ 3101-15  
frac F/ 5 bo 20 min. F/ 15 boph Comp.  
25 bopd.

Anh. Stal 2351 1171 Tp. Layton 2778  
1598 B.K.C. Cleve 3090 1910 Ce.Cleve  
Bd. 3111 1931 T.D. 3166

COMPLETED

County Sumner Elev. \_\_\_\_\_  
 Sec. 4 Twp. 35 Rge. 2E  
 Company Bowman & Grissmore  
 Farm Name Dyal No. 3

TOPS	DEPTH	LOG	DATUM	Loc. in Sec.
Anh.				<b>C SE NW</b>
Tp.				
H.				
Tr.				
Dg.				
Bl.				
L.				Geol. _____
K.C.				Contr. _____
B.K.C.				<b>Springer &amp; Harper</b>
Ce.				
C.				Pool
M.				<b>Dyal</b>
M.				
K.				
Mz.				
Mq.				
V.				
S.				
S.				
A.				
R.				
Pe.				
G.				
T.D.				

JUL 12 1953

**FIRST REPORT**

Date Comm. M I R

Co.

Lse.

No.

Sec.

T.

R.

County Sumner Elev. 1180  
 Sec. 4 Twp. 35 Rge. 2E  
 Company Bowman & Grissmore  
 Farm Name Dyal No. 3

	TOPS	DEPTH	LOG	DATUM
Anh.	<u>Stg 1</u>	<u>2351</u>		<u>1171</u>
Tp.	<u>Layton</u>	<u>2778</u>		<u>1598</u>
H.				
Tr.				
Dg.				
Bl.				
L.				
K.C.		<u>2984</u>		<u>1834</u>
B.K.C.	<u>C. level</u>	<u>3196</u>		<u>1916</u>
Ce.	<u>" sd</u>	<u>3111</u>		<u>1931</u>
C.				
M.				
M.				
K.				
Mz.				
Me.				
V.				
S.				
S.				
A.				
R.				
Pe.				
G.				
T.D.		<u>3166</u>		

Loc. in Sec. C SE NW  
 Geol. \_\_\_\_\_  
 Contr. \_\_\_\_\_  
 Pool Springer & Harper  
Dyal  


COMPLETE

Date Comm. 7-13-55 AUG 17 1955  
8 5/8" @ 134.100 5 1/2" @ 3166  
60/ 3101-15 frac F/ 5 bo 20 min.  
F/ 15 boph Comp. 25 bopd

Co. Lse. No. Sec. T. R.