

O.W.W.O.

FORM 51 25M 3-49 PETROL

KANSAS

Sumner

Section 4 Township 35 Range 2E


Well No. 1 Wentworth

Company Orville Parker

NORTH

WEST

EAST

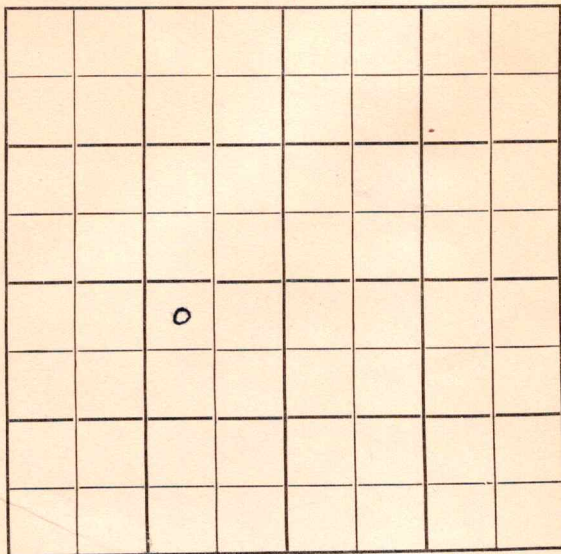

SOUTH


O.W.W.O.

Summer

KANSAS

Sec. 4 Twp. 35 R. 2EWell No. #1 Wentworth FarmOrville Parker CompanyScat Drlg. ContractorSemi Wildcat330 Ft. from N. Line Ft. from S. Line990 Ft. from E. Line Ft. from W. Line

NW NE SW

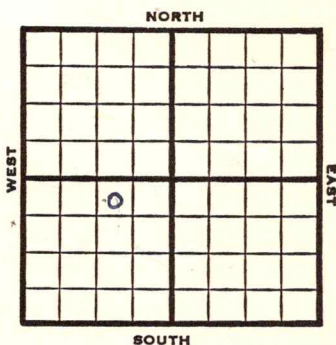

1952 Elev. 1174' REPORT

12/17 Location

1953

3/4

Spud 12-16-52

Oil Well

TD 3472

10" @ 103

Oread 2150, Stal 2340

DST 2339-50, opn $\frac{1}{2}$ hrs., rec.

32' o & g cm, 325#

Layton 2779

DST 2778-87, opnl hr., rec.

780' sw, 930#

Peru 3130, Oswego 3165, Bart

3434

DST 3459-64, opn $\frac{1}{2}$ hrs., rec.

24' ho & g cm, 795#

DST 3460-72, opn $1\frac{1}{2}$ hrs., rec.

37' o & g cm, 30' ho & g cm,

865#

5" @ 3459

TD 3472 CO to 3472 S/1 boph

500A st-lift F/47 bo 4 hrs.

Miss 3448

Comp. 25 bopd 75 bw

COMPLETED

OVER

1953

O.W.W.O.

12/2

Oil well TD 3472' Peru 3100
U. Clev 3102' L. Clev. 3129'
Bart. 3431 Miss. 3448'
OTD 3472 5" @ 3459' 52/3131-44
sd-oil-frac.
Comp. F/240 BOPD

FIRST REPORT



COMPLETED

C.W.W.O.

County Sumner State Kansas
Sec. 4 (Blk.) 35 (Sur.) 2E Map No.

Sec. 4 (Blk.) 35 (Sur.) 2E Map No.

Operator O. H. Parker

Well No. 1 Farm Wentworth

Elev.	1174	Location	NW NE SW
-------	------	----------	----------

330 Ft. From N Line SW

990 Ft. From E Line Quarter

1st. Report DEC 2 1953

Completion DEC 2 1953

Remarks OWHO

O.W.W.O.

Spudding Date

Drlg. Data Oil well TD 3472

Peru 3100 U. Clev. 3102 L. Clev. 3129

Bart. 3431 Miss. 3448 OTD 3472

5" @ 3459 52/ 3131-44 sd-oil-frac

Comp. F/ 240 bopd

J. G. McGEHEE

O.W.W.O.

County Sumner State Kansas

Sec. 4 (Blk.) 35 (Sur. Rge.) 2E Map No.

Operator O. H. Parker

Well No. 1 Farm Wentworth

Elev. 1174 Location NW NE SW



330 Ft. From N Line SW

990 Ft. From E Line Quarter

1st. Report

Completion DEC 16 1953

Remarks OWWO

O.W.W.O.

Spudding Date 12-1-53

Drig. Data Oil well TD 3472

Peru 3100 U. Clev. 3102 L. Clev. 3129

Bart. 3431 Miss. 3448 OTD 3472

5" @ 3459 52/ 3131-44 sd-oil-frac

Comp. 240 bopd

Duplicate - already F & Comp

J. G. McGEHEE

County Sumner State Kansas

Sec. 4 (Blk. 35) (Sur. 2E) Map No. _____

Operator Orville Parker

Well No. 1 Farm Wentworth

Elev.	Location	NW	NE	SW
-------	----------	----	----	----

FIRST REPORT

0

330 Ft. From N Line SW

990	Ft. From	E	Line	Quarter
-----	----------	---	------	---------

1st. Report DEC 17 1952

Completion

Remarks

Scat Drlg. - Contr.


Spudding Date _____

Drlg. Data Semi Wildcat

Location _____

J. G. McGEHEE

County Sumner State Kansas
 Sec. 4 (Blk.) 35 (Sur.) 2E Map No.
 Operator Orville Parker
 Well No. 1 Farm Wentworth
 Elev. 1174 Location NW NE SW

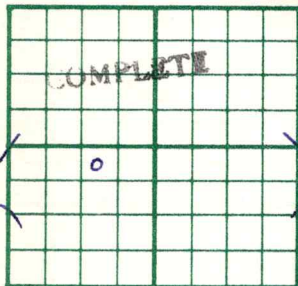

330 Ft. From N Line SW
 990 Ft. From E Line Quarter
 1st. Report
 Completion MAR 4 1953
 Remarks Semi Wildcat
 Scat Drlg. - Contr.
 Spudding Date 12-16-52

Drlg. Data Oil well TD 3472
 10" @ 103 Oread 2150 Stal. 2340
 DST 2339-50 open $\frac{1}{2}$ hr. Rec. 32' o & gcm
 325# Layton 2779 DST 2778-87
 open 1 hr. Rec. 780' sw 930#
 Peru 3130 Oswego 3165 Bart. 3434
 DST 3459-64 open $\frac{1}{2}$ hr. Rec. 24' ho &
 gcm 795# DST 3460-72 open $1\frac{1}{2}$ hr.
 Rec. 37' o & gcm 30' ho & gcm 865#
 5" @ 3459 TD 3472 CO to 3472
 S/ 1 boph 500 A st-lift F/ 47 bo 4 hr.
 Miss. 3448 Comp. 25 bopd 75 bw