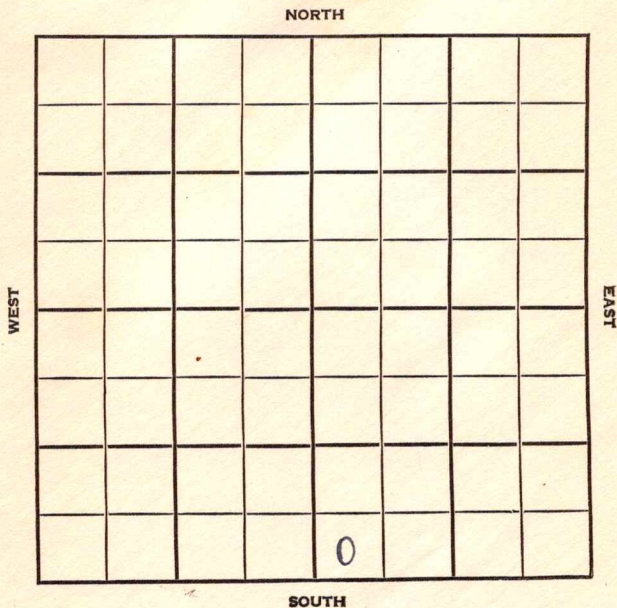


Section 11 Township 35 Range 2 EWell No. # 1 StalnakerCompany Smitherman

Sumner

SEC.	TWP.	R.
11	35	2E

KANSAS

WELL NO.

#1 Stalnaker

FARM

COMPANY

Smitherman

CONTRACTOR

Smitherman

N. Vernon Pool

Ft. from N. Line


330

Ft. from S. Line

Ft. from E. Line

330

Ft. from W. Line

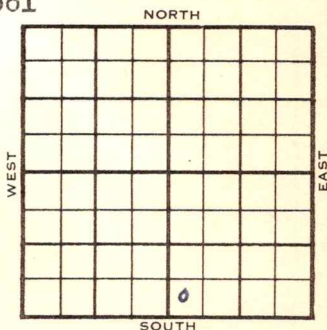

SW SW SE

	ELEVATION	REPORT
1954	1219'	

11/23 C & P

1955
1/5

Spud 11-23-54 Oil well TD 3820
8" @ 100 Stal. 2373 Layton 2814
KC 3040 Big lime 3208' Oswego 3256
Bart. 3499
DST 3499-3516 open 1½ hr rec 30' mud
230# Miss. 3526 Wilcox 3814
TD 3820 5" @ 3815 48/3504-12
2 GO^{PH} frac. P/178 BO 18 hr.
Comp. 25 BOPD

COMPLETED

NOV 24 1954

Scout Cards
Land Small Map
Land Wall Map
Trackings
Ponds Map
Pond Map
Map

Orig. Data

County Sumner State KansasSec. 11 (Blk.) 35 (Sur.) 2E Map No.Operator SmithermanWell No. 1 Farm StalnakerElev. 1219 Location SW SW SE330 Ft. From S Line SE330 Ft. From W Line Quarter

1st. Report

Completion JAN 5 1955Remarks N. Vernon PoolSmitherman - Contr.Spudding Date 11-23-54Drlg. Data Oil well TD 38208" @ 100 Stal. 2373 Layton 2814KC 3040 Big lime 3208 Oswego 3256Bart. 3499 DST 3499-3516 open 1½ hr.Rec. 30' mud 230# Miss. 3526Wilcox 3814 TD 3820 5" @ 381548/ 3504-12 2 goph fracP/ 178 bo 18 hr. Comp. 25 bopd

FABEN GILSTRAP

Scout Cards

Land Small Map

Land Wall Map

Tracings

France Map

Pierce Map

Misc.

JAN 12 1955

Orig. Data