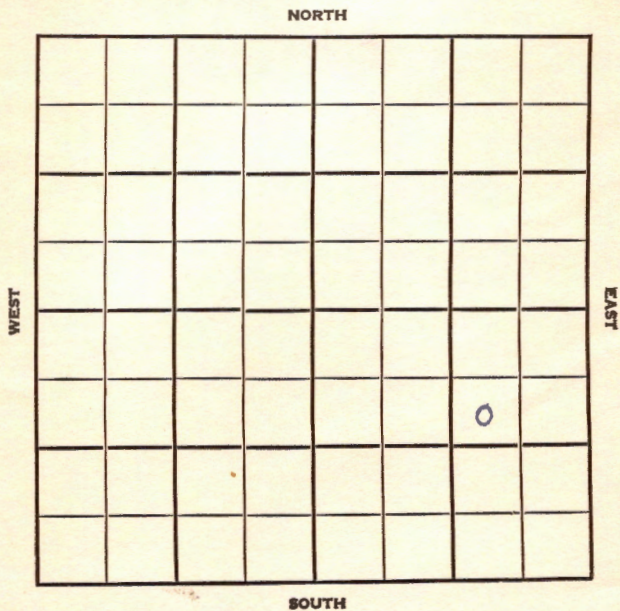


Section 11 Township 35 Range 2 EWell No. #6 Stainker "B"Company L. C. Smitherman

Sumner

KANSAS

SEC.	TWP.	R.
11	35	2E

WELL NO.

#7 Stalnaker "B"

FARM

COMPANY

L.C. Smitherman

CONTRACTOR

Co. Tools


Murphy

Ft. from N. Line

Ft. from S. Line

Ft. from E. Line

Ft. from W. Line

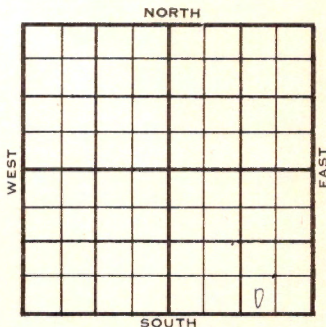

~~SW SE SE~~

SW SE SE

	ELEVATION	REPORT
1956	1203	

2-8 Location

3-14 8 5/8" @ 125
 5 1/2" @ 3463/85
 CO 30/3452-62, 10 bopd, frac
 F/ 30 boph
 COMP. F/ 25 bopd
Log Tops:
 Layton 2778
 KC 2962
 Big lm 3153
 Bart 3448
 TD 3463

COMPLETED

County Sumner Elev. 1198Sec. 11 Twp. 35 Rge. 2ECompany L. O. SmithermanFarm Name Stalnaker "B" No. 6

TOPS	DEPTH	LOG	DATUM	Loc. in Sec.
Anh.				<u>SW NE SE</u>
Tr.				
H.				
Tr.				
Dg.				
BL.				
L.				Geol.
K.C.				Contr.
B.K.C.				<u>Co. tools</u>
Ce.				
C.				Pool
M.				<u>Murphy</u>
M.				
K.				
Mz.				
Ma.				
V.				
S.				
S.				
A.				
R.				
Pe.				
G.				
T.D.				

FIRST REPORT

FEB 3 '56

Date Comm.

8" @ 125 drlg. 1930

CORRECTION

FORM 513 REV. SUNRAY

County Sumner Elev. 1203 Co.
Sec. 11 Twp. 35 Rge. 2E
Company L. C. Smitherman
Farm Name Stalnaker "B" No. 6

TOPS	DEPTH	LOG	DATUM	Loc. in Sec.
Anh.				SW SE SE
Tr.				
H.				
Tr.				
Dg.				
Bl.				
L.				Geol.
K.C.				Contr.
B.K.C.				
Ce.				
C.				
M.				
M.				Pool
K.				
Mz.				
Mq.				
V.				
S.				
S.				
A.				
R.				
Pe.				
G.				
T.D.				

CORRECTION

MAR 14 1976

Date Comm.

Reported #7

County Sumner Elev. 1203
 Sec. 11 Twp. 35 Rge. 2E
 Company L. C. Smitherman
 Farm Name Stalnaker "B" No. 6

TOPS	DEPTH	LOG	DATUM	Loc. in Sec.
Anh.				SW SE SE
Tp.				
H. <u>Layton</u>		<u>2778</u>	<u>1575</u>	
Tr.				
Dg.				
BL.				
L.				
K.C.		<u>2962</u>	<u>1759</u>	Geol.
B.K.C. <u>Big Horn</u>		<u>3153</u>	<u>1950</u>	Gentr.
Ce. <u>Bapt</u>		<u>3448</u>	<u>2245</u>	Co. tools
C.				
M.				
M.				Pool
K.				Murphy
Mz.				
Me.				
V.				
S.				
S.				
A.				
R.				
Pe.				
G.				
T.B.	<u>3463</u>			

MAR 14 1956

Date Comm.

8 5/8" @ 125 5 1/2" @ 3463/85 CO

30/ 3452-62 10 bopd frac

F/ 30 bopd Comp. F/ 25 bopd