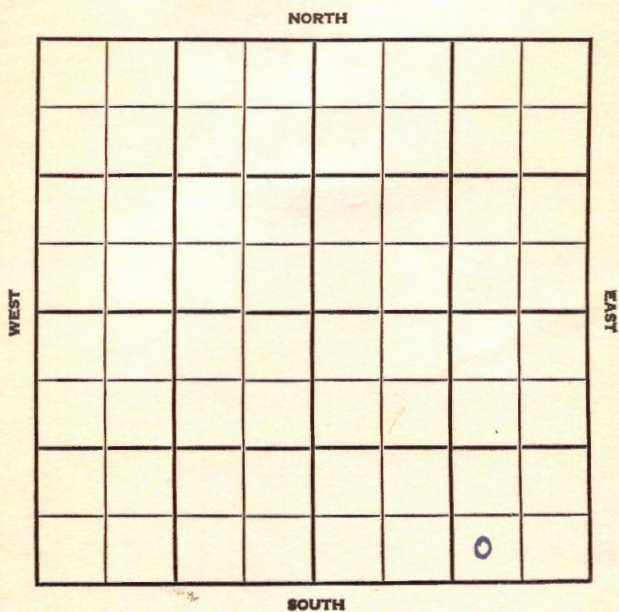


Section 11 Township 35 Range 2 EWell No. #7 Stalnaker "B"Company L. C. Smitherman

Sumner

KANSAS


SEC. 11	TWP. 35	R. 2E
------------	------------	----------

WELL NO. 7
~~#####~~ #6 Stalnaker "B" FARM
 COMPANY

L.C. Smitherman

CONTRACTOR
 Co. Tools
 Murphy

_____ Ft. from N. Line
 _____ Ft. from S. Line
 _____ Ft. from E. Line
 _____ Ft. from W. Line

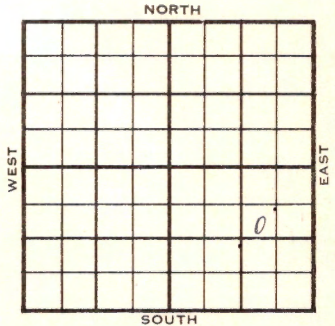

SW NE SE

1956	ELEVATION	REPORT
------	-----------	--------

1198'

2-8

8" @ 125
 Drlg. 1930

~~###~~

3-14

5½" @ 3478/85
 CO to 3474, 40/ 3462-72
 Comp. F/ 25 bopd
 Layton 2780 2783
 Bart 3450 3450
 KC 2968
 Osw. 3169
 TD 3478'

COMPLETED

CORRECTION

County Sumner

Elev. _____

Sec. 11Twp. 35Rge. 2ECompany L. C. SmithermanFarm Name Stannaker "B"No. 7

TOPS

DEPTH

LOG

DATUM

Loc. in Sec. _____

Anb. _____

Tp. _____

H. _____

Tr. _____

Dg. _____

Bl. _____

L. _____

K.C. _____

B.K.C. _____

Ce. _____

C. _____

M. _____

M. _____

K. _____

Mz. _____

Mq. _____

V. _____

S. _____

S. _____

A. _____

R. _____

Pe. _____

G. _____

T.D. _____

SW NE SE

Geol. _____

Contr. _____

Pool _____

CORRECTION

MAR 14 1956

Date Comm. _____

Reported #6

County Summer Elev. 1203
Sec. 11 Twp. 35 Rge. 2E
Company L. O. Smitherman
Farm Name Stalnaker "B" No. 7

TOPS	DEPTH	LOG	DATUM	Loc. in Sec.
Anh.				SW SE SE
Tp.				
H.				
Tr.				
Dg.				
BL.				
L.				Geol.
K.C.				Contr.
B.K.C.				Co. tools
Ce.				
C.				Pool
M.				Murphy
M.				
K.				
Mz.				
Mq.				
V.				
S.				
S.				
A.				
R.				
Pe.				
G.				
T.D.				

Date Comm. Location

FIRST REPORT
FEB 8 '55
0

County Sumner Elev. 1198
 Sec. 11 Twp. 35 Rge. 2E
 Company L. C. Smitherman
 Farm Name Stalnaker "B" No. 7

TOPS	DEPTH	LOG	DATUM	Loc. in Sec.
Anh.				SW NE SE
Tp.				
H.				
Tr.				
Dg. <u>Layton</u>	<u>2780</u>	<u>2783</u>	<u>1585</u>	
Bl. <u>B. apt</u>	<u>3450</u>	<u>3450</u>	<u>2252</u>	
L.				
K.C.		<u>2968</u>	<u>1771</u>	Geol.
B.K.C. <u>asw.</u>		<u>3169</u>	<u>1971</u>	Cantr.
Ce.				Co. tools
C.				
M.				
M.				Pool
K.				Murphy
Mz.				
Me.				
V.				
S.				
S.				
A.				
R.				
Pe.				
G.				
T.D.	<u>3478</u>			

MAR 14 1976

Date Comm.

5 1/2" @ 3478/85 CO to 3474 40/ 3462-72

Comp. F/ 25 bopd