

Sumner


**KANSAS**

SECTION 11 TOWNSHIP 35 RANGE 2E

WELL NO. #11 Stalnaker "B"

COMPANY L.C. Smitherman

NORTH C E/2 NE SE

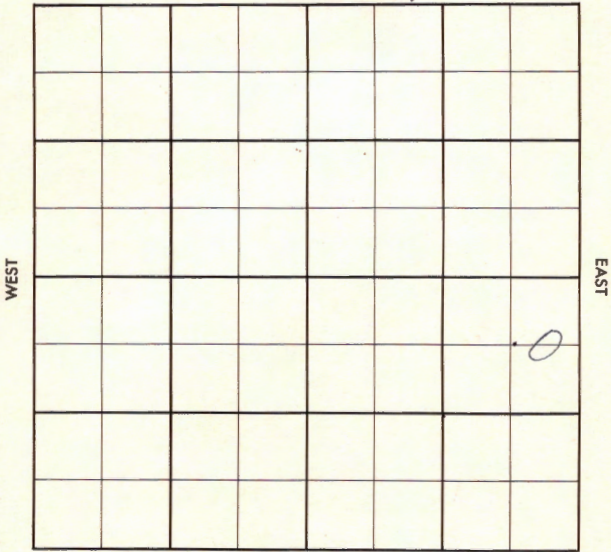

SOUTH

Co.

County Sumner Elev. \_\_\_\_\_  
 Sec. 11 Twp. 35 Rgs. 2E  
 Company J. C. Smitherman  
 Farm Name Stalcker "B" No. 11

TOPS	DEPTH	LOG	DATUM
Anh.			
Tr.			
H.			
Tr.			
Dg.			
Bl. <u>Dart</u>	<u>3479</u>		
L.			
K.C.			
B.K.C.			
Ce.			
C.			
M.			
M.			
K.			
Mz.			
Me.			
V.			
S.			
S.			
A.			
R.			
PE.			
G.			
T.D. <u>3492</u>	<u>3494</u>		

Loc. in Sec. \_\_\_\_\_  
 Geol. \_\_\_\_\_  
 Contr. Co. tools  
 Pool \_\_\_\_\_  
Murphy  
**COMPLETE**  
 MAY 22 '57

Loc.

No.

Sec.

T.

R.

Date Comm. 1-22-57  
PH @ 120/100 drilo. 2:00 MAY 8 57

5 1/2 3482 MAY 15 57 DD 3504  
\$ 20 Bo n/w in 24 hrs TO  
FRAC MAY 22 57 Frac didn't take  
\$ 1 3/4. Bufr n/w 16 hrs  
Pop comp P. 25 Boyd  
n/w

County Sumner Elev. \_\_\_\_\_  
 Sec. 11 Twp. 35 Rge. 2E  
 Company L. C. Smitherman  
 Farm Name Stalnaker "B" No. 11

TOPS	DEPTH	LOG	DATUM	Loc. in Sec.																
Anh.				C E $\frac{1}{2}$ NE SE																
Tp.																				
H.																				
Tr.																				
Dg.																				
Bl.																				
L.				Geol. _____																
K.C.				Contr. _____																
B.K.C.																				
Ce.				Co. tools																
C.																				
M.				Pool																
M.				Murphy																
K.				<table border="1"> <tr> <td></td> <td></td> <td></td> <td></td> </tr> <tr> <td></td> <td></td> <td></td> <td></td> </tr> <tr> <td></td> <td></td> <td></td> <td></td> </tr> <tr> <td></td> <td></td> <td></td> <td></td> </tr> </table>																
Mz.																				
Ma.																				
V.																				
S.																				
S.																				
A.																				
R.																				
PE.																				
G.																				
T.B.																				

Date Comm. 4-22-57  
8" @ 120/100 drlg. 2400

*29*

Co.  
No.  
Sec.  
T.  
R.

FIRST REPORT

MAY 1 1957