


Summer
Form 51-5M-9-28-27423
Map No. **KANSAS** Sec. 11 Twp. 35^S R. 2^E
Well No. 2 - Stonaker Farm
Ark River Company

NORTH

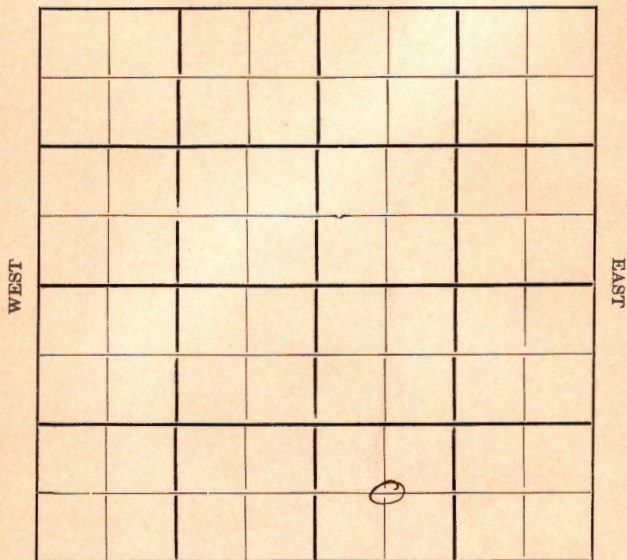

SOUTH

Location.....

Drilling Remarks

Rig Up.....

Drilling Remarks

RECORD

Cased..... in..... ft.

Sand.....

Gas.....

Oil.....

Total Depth.....

PRODUCTION

1st 24 hrs. Nat.....

1st 24 hrs. after shot.....

Gas..... cu. ft.....

Dry Hole.....

Abandoned.....

Map No. Sec. Twp. R.

Well No. Farm


..... Company

.....Ft. from N. Line

.....Ft. from S. Line

.....Ft. from E. Line

.....Ft. from W. Line

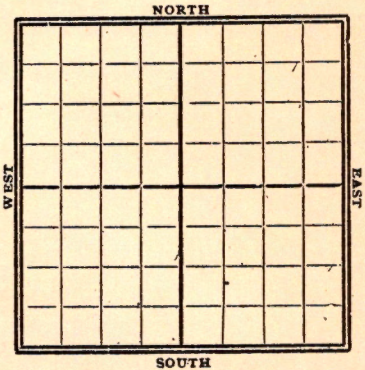

1920

Date

REPORT

Gypsy Records

12/29

*Rig torn down.
Loc Abd.*

Shinner
 K1 MAP NO. **KANSAS** SEC. *11* TWP. *35S 2E*
 WELL NO. *2 Stonaker*
Arkansas River COMPANY

CONTRACTOR

SECTION PLAT

ABANDONED

_____ FT. FROM N. LINE

_____ FT. FROM S. LINE

_____ FT. FROM E. LINE

_____ FT. FROM W. LINE

RECORD

LOCATION _____

CASED _____ IN. _____ FT.

RIG UP _____

SAND _____

DRILLING AND REMARKS:

GAS _____

OIL _____

TOTAL DEPTH _____

PRODUCTION

1ST 24 HRS. NAT. _____

1ST 24 HRS. AFTER SHOT _____

GAS _____ CU. FT.

DRY HOLE _____

ABANDONED _____

Rig torn down
7/9/21
abandoned

DATE

12-29 1920 SCOUT