


Sumner

KANSAS

SECTION 12 TOWNSHIP 35 RANGE 2E

WELL NO. #3 Dean "A"

COMPANY Holiday Oil & Gas

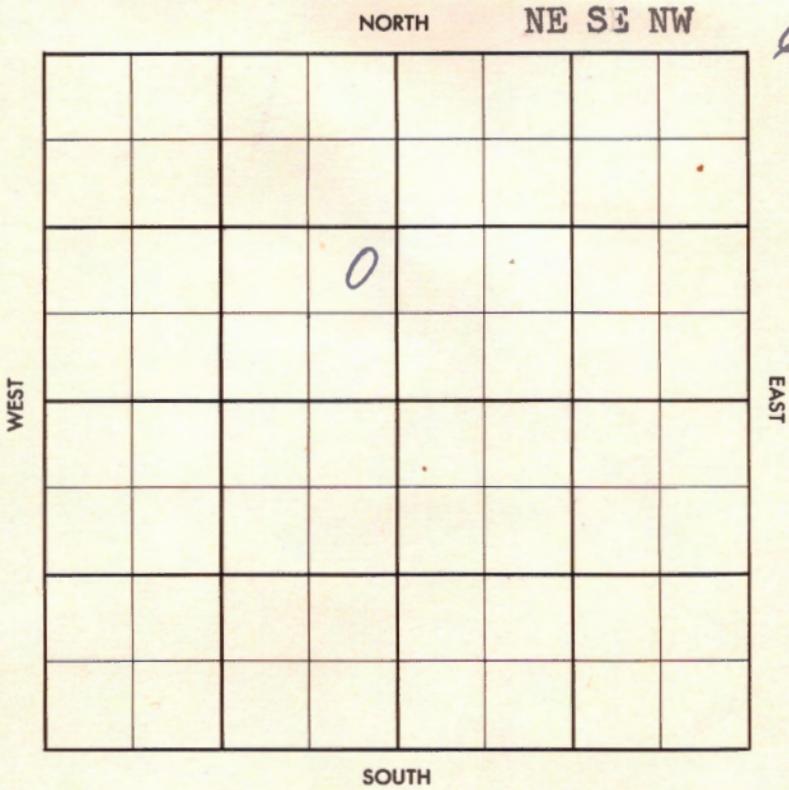

County Sumner Elev. \_\_\_\_\_  
 Sec. 12 Twp. 35 Rgs. 2E  
 Company Holiday Oil & Gas  
 Farm Name Dean "A" No. 3

TOPS	DEPTH	LOG	DATUM	Loc. in Sec.
Anh.				NE SE NW
Tp.				
H.				
Tr.				
Dg.				
Bl.				
L.				Geol. _____
K.C.				Contr. _____
B.K.C.				H. Martin
Ce.				Pool _____
C.				Murphy
M.				
M.				
K.				
Mz.				
Me.				
V.				
S.				
S.				
A				
R.				
Pe.				
G.				
T.D.				

FIRST REPORT  
 JUL 31 1957

Date Comm. M I R T

~~29~~

Co.  
Lse.  
No.  
Sec.  
T.  
R.

County Sumner Elev. 1203  
 Sec. 12 Twp. 35 Rge. 2E  
 Company Holiday Oil & Gas  
 Farm Name Dean "A" No. 3

TOPS	DEPTH	LOG	DATUM	Loc. in Sec.
Anh.				NE SE NW
TP.				
H.				
Tr.				
Dg.				
Bl. <u>Bartl sd</u>		<u>3504</u>		
L.				Geol.
K.C.				Contr.
B.K.C.				<u>H. Martin</u>
Ce.				Pool
C.				<u>Murphy</u>
M.				
M.				
K.				
Mr.				
Me.				
V.				
S.				
S.				
A.				
R.				
Pe.				
G.				
TD.	<u>3550</u>			

OCT 2 '57  
 o  
 COMPLETE

Date Comm. M I R T 7-30-57 85/8 206  
17320d DST 3500-12  
1hr G/S" rec 390' oil +100'  
H0 8' GCM BHT 575/20" 5/2  
3545/woc. AUG 27 '57 AUG 28 '57 SEP 4 '57  
SEP 11 '57 CO 20/3504-09 frac Flw  
10 BOPh no w SEP 25 '57 SEP 2 '57  
25 BOPd  
Bart 3504-09