


KANSAS

Sumner county

Section 12 Township 35 Range 2-E

Well No. #1, Jones

Company Max Cohen

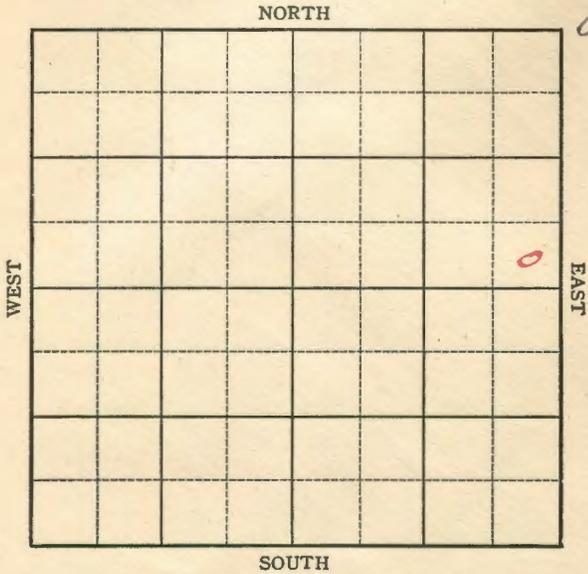

KANSAS

Sumner ✓

Sec. 12 Twp. 35 R. 2E

Well No. #1 Jones Farm _____

Max Cohen Company _____


Miscellaneous _____

_____ Ft. from N. Line

330 Ft. from S. Line

330 Ft. from E. Line

_____ Ft. from W. Line

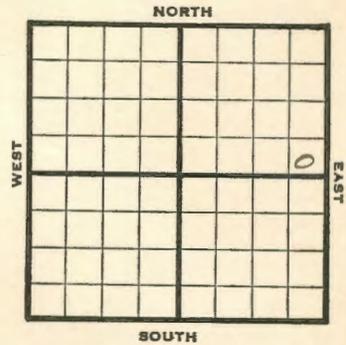

SE NE

1946 **Elev. 1200** REPORT

11/6 Location
 11/12 RUR
 11/20 8" @ 130
 Drlg 1315'
 11/27 Drlg 2700'
 12/3 **Bart zon3 3434-67 TD**
 5" @ 3 455 WOC
 12/10 TD 3502'
 90 qts 3464-3500'
 Est 400 a day
 12/17 " "

1947
 1/2 **Bart Sand 3463'**
 5" @ 3455'
 TD 3502'
 90 qts 3464-3500'
 Pump 400 POT
 40 Grav.

COMPLETED

Map No. 1 Sec. 12 Twp. 35 R. 2E

Well No. 1 Jones

Max Cohen Company

COMPLETED Contractor

SE NE


E1,1205
SECTION PLAT

 Ft. from N. Line

330 Ft. from S. Line

330 Ft. from E. Line

 Ft. from W. Line

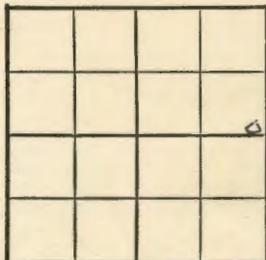

Sumner County

Location

Rig up

Drilling and Remarks:

Bar 2 263463
5' @ 3455
909 to 8464 - 8570
Pump 400 ft

40242

RECORD

Cased in, ft.

Sand

Gas

Oil

Total Depth 3572

PRODUCTION

1st 24 hrs. Nat.

1st 24 hrs. after shot

Gas Cu. Ft.

Dry Hole

Abandoned

Date

JAN 2 1947

19

S. J. LEWIS

Scout

Map No. 1 Sec. 12 Twp. 35 R. 2E

Well No. 1 Jones

Max Cohen Company

FIRST REPORT Contractor

SE NE


SECTION PLAT

 Ft. from N. Line

330 Ft. from S. Line

330 Ft. from E. Line

 Ft. from W. Line

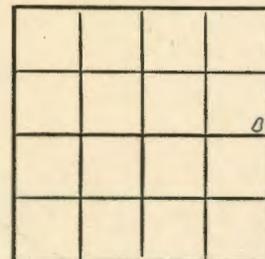

Sumner County

Location X

Rig up

Drilling and Remarks:

RECORD

Cased in, ft.

Sand

Gas

Oil

Total Depth

PRODUCTION

1st 24 hrs. Nat.

1st 24 hrs. after shot

Gas Cu. Ft.

Dry Hole

Abandoned

Date

NOV 6 1946

19

S. J. LEWIS

Scout