


Section 13 Township 35 Range 2 E

Well No. # 4 Bowman

Company Royal Oil

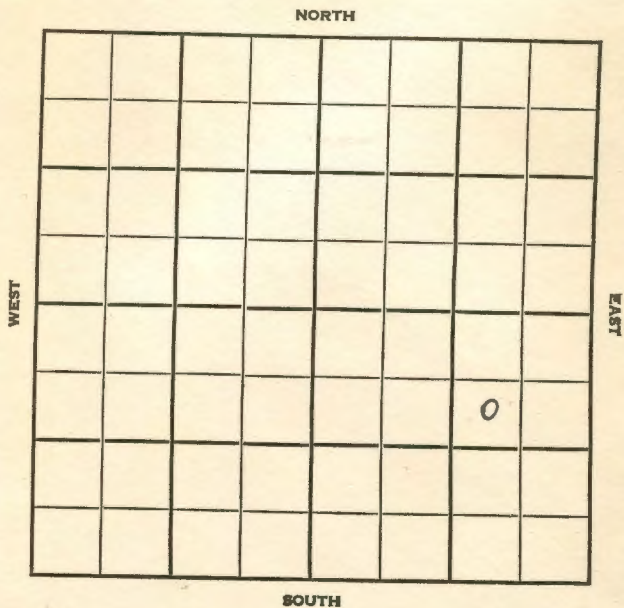

| | | |
|----|----|-----|
| 13 | 35 | 2 E |
|----|----|-----|

WELL NO. # 4 Bowman FARM

COMPANY Royal Oil

CONTRACTOR Co. tools

SW Murphy Pool


990 Ft. from N. Line

Ft. from S. Line

990 Ft. from E. Line

Ft. from W. Line

SW NE SE

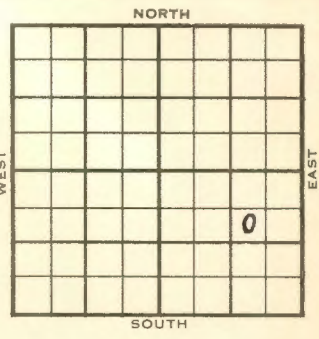

| | | |
|------|-----------------|--------|
| 1955 | ELEVATION 1189' | REPORT |
|------|-----------------|--------|

2/9 Spud 2-6-55
Drlg. 500'

3/16 Spud 2-6-55; oil well, TD 3599,
Layton 2833, KC 3066, Cleve
3162, Oswego 3225, Miss 3574,
TD 3599, 5" @ 3225, PB 3230,
26/3162-70 frac S/83 BO 40 BW
Comp. 70 BOPd 25 BW

COMPLETED

