


KANSAS

Section 13 Township 35 Range 2E


Well No. #1 Collinson #G# 1 Grover

Company McNeish & Gralapp

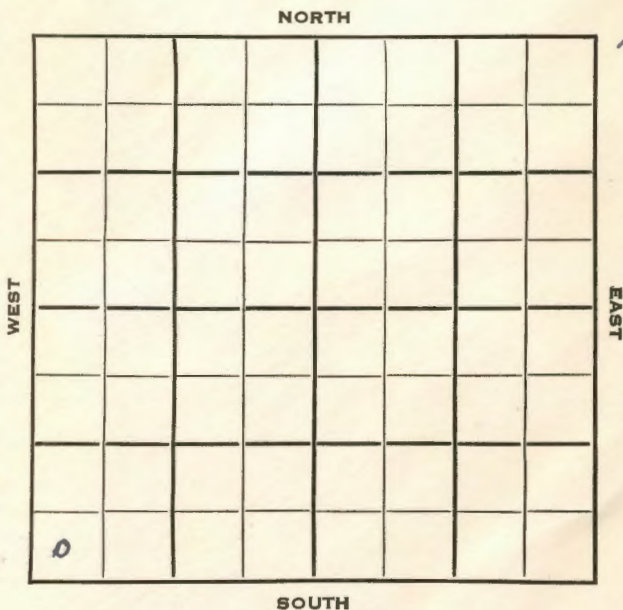

SEC.	13	TWP.	35	R.	2E ✓
WELL NO.	Grover 1-Collinson #G#			FARM	
COMPANY	McNeish & Gralapp				
CONTRACTOR	Watson Drlg. N. Vernon Pool				

\_\_\_\_\_ Ft. from N. Line  
 330 \_\_\_\_\_ Ft. from S. Line  
 \_\_\_\_\_ Ft. from E. Line  
 330 \_\_\_\_\_ Ft. from W. Line

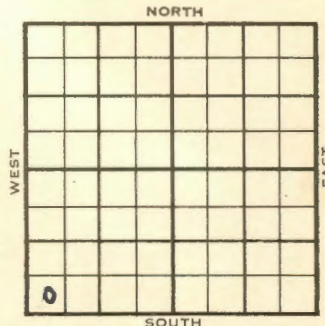

SW SW SW

1954	ELEVATION	REPORT
	1207'	

2/24 Spud 2-22-54  
 8" @ 102', WOC

3/24 Spud 2-22-54  
 OilWell  
 TD 3187'  
 8" @ 102'  
 Layton 2856', KC 3048', Cleveland 3168'  
 TD 3187'  
 5" @ 3171'  
 CO to 3187'  
 sd-frac F/ 71 boph  
 Comp 30 bopd.

COMPLETED



KANNA

Map No. \_\_\_\_\_ Sec. 13 Twp. 35 R. 2E

Well No. 1 Grover

McNeish & Gralapp Company

**CORRECTION** Contractor

SW SW SW

SECTION PLAT

\_\_\_\_\_ Ft. from N. Line

330 Ft. from S. Line

\_\_\_\_\_ Ft. from E. Line

330 Ft. from W. Line


Sumner County

Location \_\_\_\_\_

Rig up \_\_\_\_\_

Drilling and Remarks:

Reported  
#1 Collinson "C"

RECORD

Cased \_\_\_\_\_ in., \_\_\_\_\_ ft.

Sand \_\_\_\_\_

Gas \_\_\_\_\_

Oil \_\_\_\_\_

Total Depth \_\_\_\_\_

PRODUCTION

1st 24 hrs. Nat. \_\_\_\_\_

1st 24 hrs. after shot \_\_\_\_\_

Gas \_\_\_\_\_ Cu. Ft.

Dry Hole \_\_\_\_\_

Abandoned \_\_\_\_\_

Date

MAR 4 1954  
19

J. G. McGEHEE Scout