

W.O.


Sumner

KANSAS

Section 15 Township 35 Range 2-E

Well No. 5 Herrick

Company Sinclair-Prairie

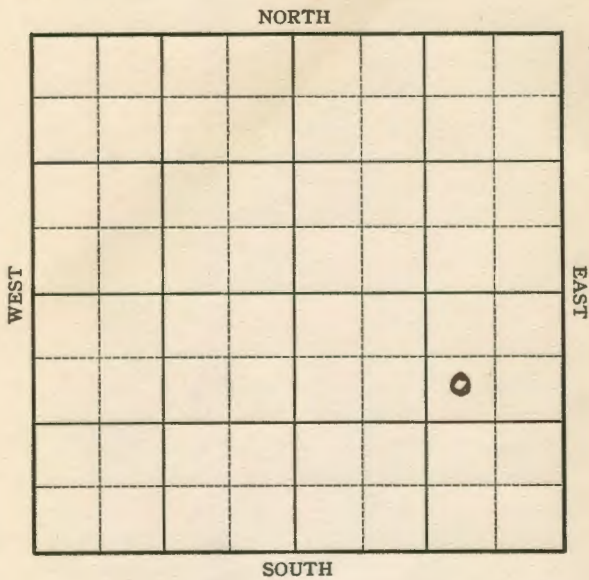


Sec. 15 Twp. 35 R. 2-E

Well No. #5 Herrick Farm

Sinclair-Prairie Company

990 Ft. from N. Line
 _____ Ft. from S. Line
990 Ft. from E. Line
 _____ Ft. from W. Line

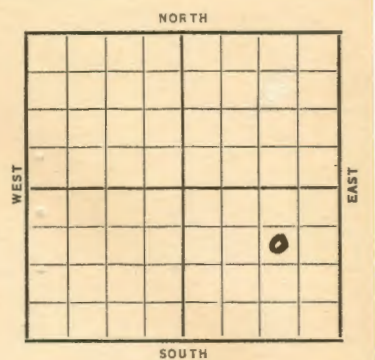

SW NE SE
Elev. 1153

Date	REPORT
1937	
12/1	Cellar.
12/10	Mat.
12/17	R U R
12/24	10" @ 121', Drlg. 576'.
12/31	Drlg. 2284'.
1938	
1/7	Drlg. 3190'.
1/14	Bart. 3396'. T.D. 3419'.
	No shows. 7" @ 3415'???
	RUST.
1/20	7" - 3402' T.D. 3424'
	No Shows. Cem. cave.
1/28	Chat. 3453' T.D. 3459' no shows
	Fishing.
2/4	TD 3459' Shot 20 qts 3435-50' Swabbing 15 bbls oil per day.
2/11-	" " " " "
2/18	" " " Testing.
2/26	" " " " "
3/4	" " " " "

OVER

1938

3/9

7" @ 3402'.

Chat 3453'.

T.D. 3458'.

Shot 20 qts.

Potential 15 bbls.

COMPLETED

O.W.W.O.

1954

3/24

Gas Well

TD 3458'

7" @ 3402'

OTD 3458'

Stal. 2332', Layton 2747', KC 2951',

Cleveland 3078', Oswego 3146', Bart

3404', Miss 3446'

PB 3100'

69/3086-96

Hydro

Comp. for shut in gas well 2,220,000

ofgpd

FIRST REPORT
COMPLETED

Map No. / Sec. 15 Twp. 35 R. 2E

Well No. 5 Herrick

Sinclair Prairie Company

Contractor

COMPLETED

SECTION PLAT

SW NE SE
990 Ft. from N. Line
Ft. from S. Line
990 Ft. from E. Line
Ft. from W. Line

			0

Location _____

Rig up _____

Drilling and Remarks:

*shot 20 gals
Pot
15 bbl/s*

RECORD

Cased 7 in., 3402 ft.
Sand Chat 3453
Gas _____
Oil _____
Total Depth 3458

PRODUCTION

1st 24 hrs. Nat. _____
1st 24 hrs. after shot _____
Gas _____ Cu. Ft.
Dry Hole _____
Abandoned _____

Date

MAR 9 - 1938

H. D. Hatfield Scout

Map No. / Sec. 15 Twp. 35 R. 2E

Well No. 5 Herrick

Sinclair Prairie Company

Contractor

FIRST REPORT

SECTION PLAT

SW NE SE
990 Ft. from N. Line
Ft. from S. Line
990 Ft. from E. Line
Ft. from W. Line

			0

Location _____

Rig up _____

Drilling and Remarks:

Cellar

RECORD

Cased _____ in., _____ ft.
Sand _____
Gas _____
Oil _____
Total Depth _____

PRODUCTION

1st 24 hrs. Nat. _____
1st 24 hrs. after shot _____
Gas _____ Cu. Ft.
Dry Hole _____
Abandoned _____

Date

DEC 1 - 1937

H. D. Hatfield Scout