

Sumner


KANSAS

Sumner


Section 15 Township 35 Range 2-E  
Well No. #6 Herrick  
Company Sinclair Prairie

Sec. 15 Twp. 35 R. 2-E  
Well No. #6 Herrick Farm  
Sinclair-Prairie Company  
(North Vernon)

NORTH No. Vernon Pool

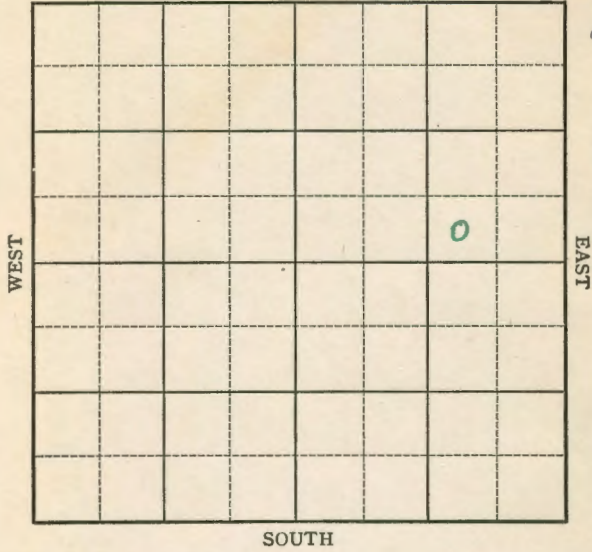

\_\_\_\_\_ Ft. from N. Line  
330 Ft. from S. Line  
990 Ft. from E. Line  
\_\_\_\_\_ Ft. from W. Line

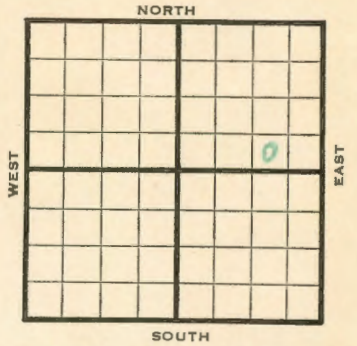

**Elev. 1151**

1942

REPORT

6/24 Location  
7/1 Derrick.  
7/8 10" - 99' Drlg. 1605'  
7/15 Drlg. 3165'  
7/22 **Bart. 3392** 7" - 3394'  
Oil 3422 B. Sand 3437  
**Miss. 3437** T.D. 3440- 1600' oil  
7/29 60 qts. 3421-37  
Swab 25 oil 1/2 hr C.O.  
8/5 **Bart. 3392'**  
7" - 3394'  
**Miss. 3437'**  
T.D. 3440  
60 qts. 3421-37  
Pump 261 Pot.

**COMPLETED**

Map No. / Sec. 15 Twp. 35 R. 2E

Well No. 6 Herrick

Sinclair Prairie Company

FIRST REPORT Contractor

SW SE NE

SECTION PLAT

Ft. from N. Line

330 Ft. from S. Line

990 Ft. from E. Line

Ft. from W. Line

			o

NORTH VERNON POOL

Location XXX

RECORD

Cased in. ft.

Sand

Gas

Oil

Total Depth

PRODUCTION

1st 24 hrs. Nat.

1st 24 hrs. after shot

Gas Cu. Ft.

Dry Hole

Abandoned

Date

JUN 24 1942 19

S. J. LEWIS

Scout

Map No. / Sec. 15 Twp. 35 R. 2E

Well No. 6 Herrick

Sinclair-Prairie Company

COMPLETED Contractor

SW SE NE

SECTION PLAT

Ft. from N. Line

330 Ft. from S. Line

990 Ft. from E. Line

Ft. from W. Line

			o

NORTH VERNON POOL

Location

RECORD

Cased in. ft.

Sand

Gas

Oil

Total Depth 3440

PRODUCTION

1st 24 hrs. Nat.

1st 24 hrs. after shot

Gas Cu. Ft.

Dry Hole

Abandoned

Date

AUG 5 1942 19

S. J. LEWIS

Scout

Bar Y3392  
 2" @ 3394  
 Miss 3487  
 609 to 3487  
 3421-37  
 Pump 26/Pr Y