

FORM 51 5M PETROL

Sec. 15 Twp. 35 R. 2E

Section 15 Township 35 Range 2E

Well No. 4 Horton

Company Smith & Horton

Well No. #4 Horton Farm

Smith & Horton Company

Miscellaneous


990 Ft. from N. Line

Ft. from S. Line


Ft. from E. Line

300 Ft. from W. Line

SW NW NW

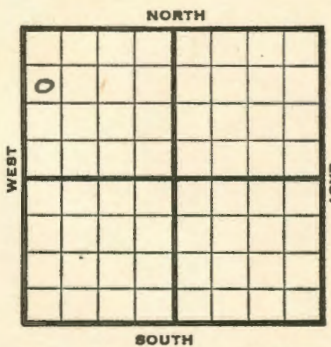

NORTH

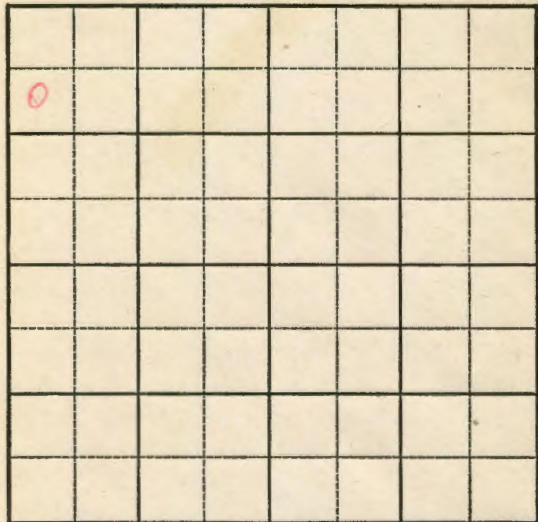

SOUTH

REPORT

1945 Elev. 1176

10/31 Location

11/7 10" @ 83  
Drlg. 1400'

11/14 Drlg. 3025'

11/21 Miss. 3400  
TD 3405  
5" @ 3400  
RUST

11/28 Miss. 3400  
5" @ 3400  
TD 3445  
Pump 100 Pot.  
Grav. 38.0

COMPLETED

**KANSAS**

Kansas Pool Name Miscellaneous

Map No.     /     Sec. 15 Twp. 35 R. 2E

Well No. 4 Horton

Smith and Horton Company

**COMPLETED**

Contractor

SW NW NW

*E11176*  
SECTION PLAT

990 Ft. from N. Line

    Ft. from S. Line

    Ft. from E. Line

330 Ft. from W. Line


Sumner County

Location    

Rig up    

Drilling and Remarks:

*Misc 3400  
5" @ 3400  
Pump 100 ft*

**RECORD**

Cased     in.,     ft.  
Sand      
Gas      
Oil      
Total Depth 3445

**PRODUCTION**

1st 24 hrs. Nat.      
1st 24 hrs. after shot      
Gas     Cu. Ft.  
Dry Hole      
Abandoned    

Date

NOV 28 1945 19 S. J. LEWIS Scout

**KANSAS**

Kansas Pool Name Miscellaneous

Map No.     /     Sec. 15 Twp. 35 R. 2E

Well No. 4 Horton

Smith & Horton Company

**FIRST REPORT**

Contractor

SW NW NW

SECTION PLAT

990 Ft. from N. Line

    Ft. from S. Line

    Ft. from E. Line

330 Ft. from W. Line


Sumner County

Location    

Rig up    

Drilling and Remarks:

**RECORD**

Cased     in.,     ft.  
Sand      
Gas      
Oil      
Total Depth    

**PRODUCTION**

1st 24 hrs. Nat.      
1st 24 hrs. after shot      
Gas     Cu. Ft.  
Dry Hole      
Abandoned    

Date

OCT 31 1945 19 S. J. LEWIS Scout