


Map No. **KANSAS** Sec. *15* Twp. *35<sup>S</sup>* R. *2<sup>E</sup>*  
Well No. *2 - W. Perkins* Farm  
*Ark River Gas* Company

NORTH

*2*

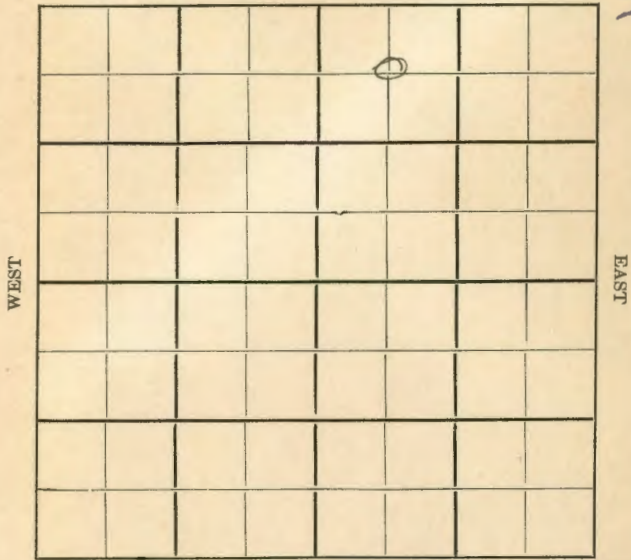

SOUTH

Location.....  
Drilling Remarks.....

Rig Up.....  
Drilling Remarks.....


**RECORD**  
Cased..... in..... ft.  
Sand.....  
Gas.....  
Oil.....  
Total Depth.....

**PRODUCTION**  
1st 24 hrs. Nat.....  
1st 24 hrs. after shot.....  
Gas..... cu. ft.....  
Dry Hole.....  
Abandoned.....

Map No..... Sec..... Twp..... R.....  
Well No..... Farm  
..... Company

NORTH

..... Ft. from N. Line  
..... Ft. from S. Line  
..... Ft. from E. Line  
..... Ft. from W. Line

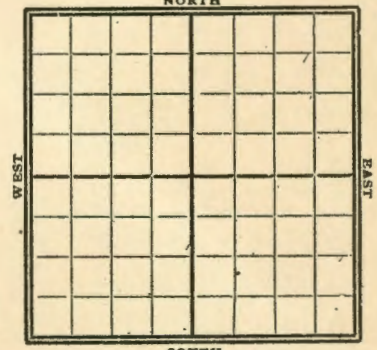

*1921*  
Date

REPORT

*Gypsy Records*  
*OWDD*  
*Plugged*  
*Abd T.D. 1540'*

MAP NO. K1 KANSAS SEC. 15 TWP. 35S R. 2E

WELL NO. 2 H. Renberg

Rob. Quinn Co COMPANY

CONTRACTOR

SECTION PLAT

		0	

FT. FROM N. LINE

FT. FROM S. LINE

FT. FROM E. LINE

FT. FROM W. LINE

LOCATION \_\_\_\_\_

RIG UP \_\_\_\_\_

DRILLING AND REMARKS:

*plugged  
wire shown  
1545*

RECORD

CASED \_\_\_\_\_ IN. \_\_\_\_\_ FT.

SAND \_\_\_\_\_

GAS \_\_\_\_\_

OIL \_\_\_\_\_

TOTAL DEPTH 1540

PRODUCTION

1ST 24 HRS. NAT. \_\_\_\_\_

1ST 24 HRS. AFTER SHOT \_\_\_\_\_

GAS \_\_\_\_\_ CU. FT.

DRY HOLE

ABANDONED

DATE

7/9 1921

SCOUT

*old well drilled deeper*

**ABANDONED**