


Section 16 Township 35 Range 2E

Well No. #2 Lawson

Company Greeley Drlg

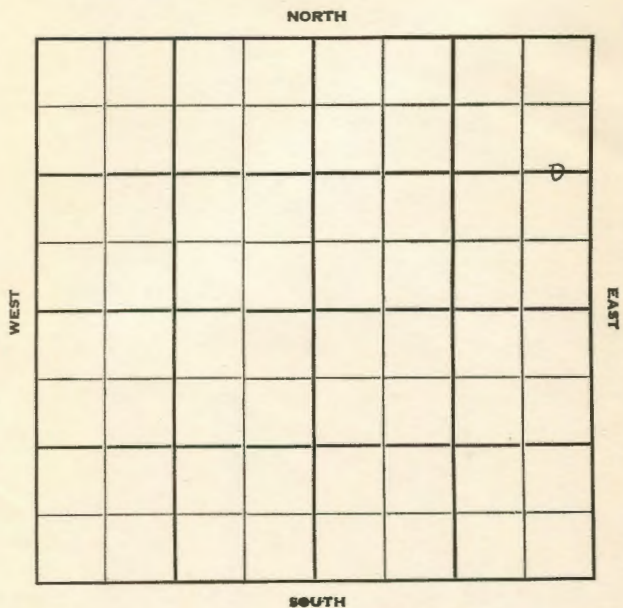

Sec. 16 Twp. 35 R. 2-E ✓

Well No. #2 Lawson Farm

Greeley Drlg. Company


Greeley Drlg. Contractor

 Ft. from N. Line

1320 Ft. from S. Line

330 Ft. from E. Line

C E/2 E/2 NE Ft. from W. Line

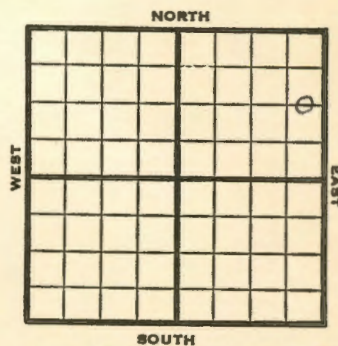

1950 **Elev 1168'** REPORT

12/13 Spud 12-9-50
8" @ 60
Drlg 440'

1951
1/3 Spd 12-9-50
D&A TD 3458
8" @ 60' **Neva 804**
Stal. 2338' Iton 2289
Miss 3418' TD 3458'
D&A **ABANDONED**

