


KANSAS

Summer

Section 16 Township 35 Range 2E  
 Well No. 2 Lawson  
 Company Smith & Horton

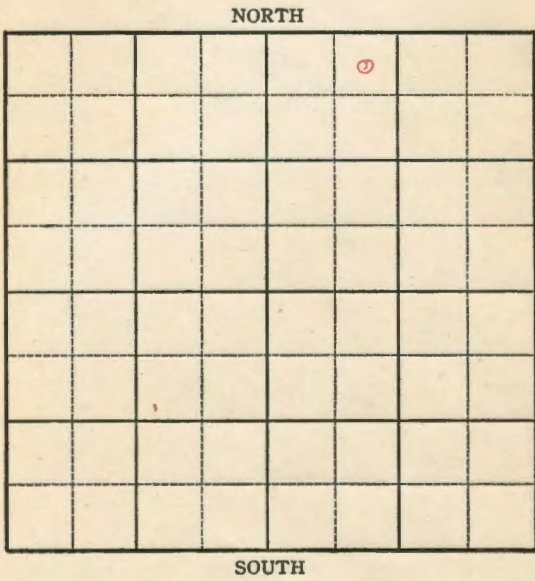


KANSAS

Summer

Sec. 16 Twp. 35 R. 2-E  
 Well No. #2 Lawson Farm \_\_\_\_\_  
Smith & Horton Company \_\_\_\_\_

330 Ft. from N. Line  
 \_\_\_\_\_ Ft. from S. Line  
 \_\_\_\_\_ Ft. from E. Line  
990 Ft. from W. Line

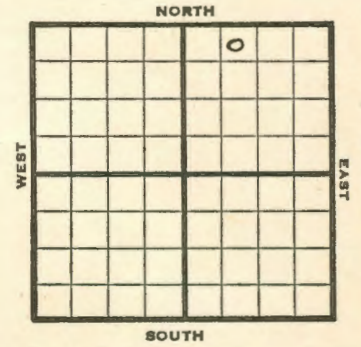

NE NW NE

1945 Elev. 1146 REPORT

11/28 RUR  
 12/5 10" @ 75  
 Drlg. 2130'  
 12/12 Miss. 3405-3417  
 TD 3417  
 Run 7"  
 12/20 7" - 3405' RUST.  
 12/29 " " "  
 1946  
 1/9 Miss. 3405  
 7 @ 3405  
 20 qts. 3409-3418  
 ED 3424  
 Pump 20 Pot.  
 Grav. 36.0

COMPLETED

KANSAS

Kansas Pool Name Miscellaneous

Map No. 1 Sec. 16 Twp. 35 R. 2E

Well No. 2 Lawson

Smith and Horton Company

**COMPLETED**

Contractor

NE NW NE

SECTION PLAT

330 Ft. from N. Line

\_\_\_\_\_ Ft. from S. Line

\_\_\_\_\_ Ft. from E. Line

990 Ft. from W. Line

			6

Summer County

Location \_\_\_\_\_

Rig up \_\_\_\_\_

Drilling and Remarks:

*Min 3405*  
*7" @ 3405*  
*209 to 3409 - 18*  
*Pump 20 RT*  
*362-80*

RECORD

Cased \_\_\_\_\_ in., \_\_\_\_\_ ft.

Sand \_\_\_\_\_

Gas \_\_\_\_\_

Oil \_\_\_\_\_

Total Depth 3424

PRODUCTION

1st 24 hrs. Nat. \_\_\_\_\_

1st 24 hrs. after shot \_\_\_\_\_

Gas \_\_\_\_\_ Cu. Ft.

Dry Hole \_\_\_\_\_

Abandoned \_\_\_\_\_

Date

JAN 9 1946 19

S. J. LEWIS Scout

KANSAS

Kansas Pool Name Miscellaneous

Map No. 1 Sec. 16 Twp. 35 R. 2E

Well No. 2 Lawson

Smith and Horton Company

**FIRST REPORT**

Contractor

NE NW NE

SECTION PLAT

330 Ft. from N. Line

\_\_\_\_\_ Ft. from S. Line

\_\_\_\_\_ Ft. from E. Line

990 Ft. from W. Line

			6

Summer County

Location \_\_\_\_\_

Rig up \_\_\_\_\_

Drilling and Remarks:

RUR

RECORD

Cased \_\_\_\_\_ in., \_\_\_\_\_ ft.

Sand \_\_\_\_\_

Gas \_\_\_\_\_

Oil \_\_\_\_\_

Total Depth \_\_\_\_\_

PRODUCTION

1st 24 hrs. Nat. \_\_\_\_\_

1st 24 hrs. after shot \_\_\_\_\_

Gas \_\_\_\_\_ Cu. Ft.

Dry Hole \_\_\_\_\_

Abandoned \_\_\_\_\_

Date

NOV 28 1945 19

S. J. LEWIS Scout