


Map No. **KANSAS** Sec. 16 Twp. 35 R. 2E

Well No. 1-Mynes Farm
Fred Morgan's Lease Company

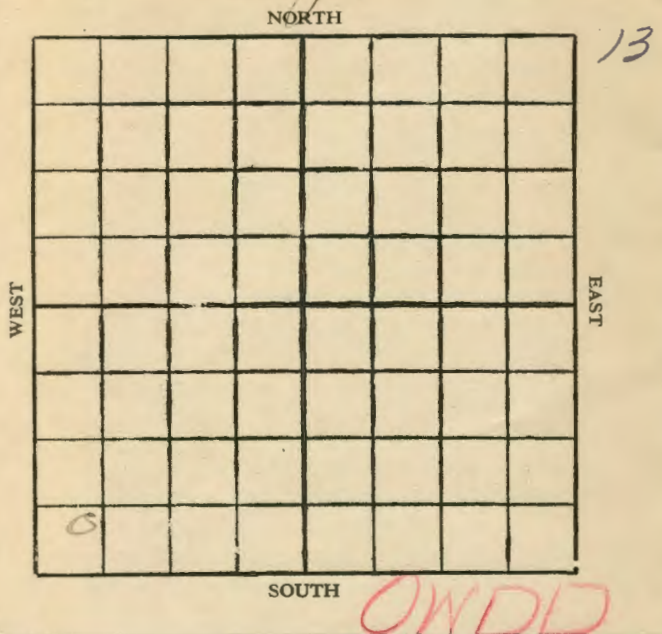


Location	Rig Up.....
Drilling Remarks	Drilling Remarks

RECORD		PRODUCTION	
Cased	in. ft.	1st 24 hrs. Nat.	
Sand		1st 24 hrs. after shot	
Gas		Gas	cu. ft.
Oil		Dry Hole	
Total Depth		Abandoned	

Map No. **KANSAS** Sec. 16 Twp. 35 R. 2E

Well No. 1-Mynes Farm
Fred Morgan's Lease Company

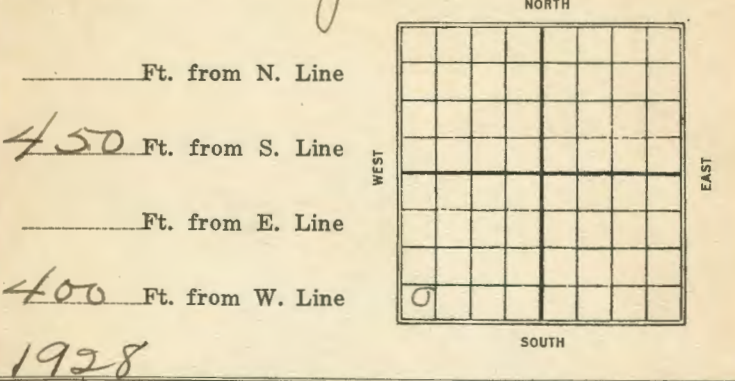

Date	REPORT
3/7	Spud
3/14	Drly 512
3/21	" 740
3/28	" 1310
4/4	" 1760 - Show gas 1576
4/11	" 1905 - 8" @ 1900
4/18	T.D. 2000 - S.D.
4/25	---
5/2	---
5/9	---
5/16	Drly 2040.
5/23	Top sand 2350 - Show oil & gas H.F.W. 2356 -
5/31	T.D. 2356 - S.D.
6/6	---
6/13	T.D. 2356 - Straight run 10"
6/20	Sand 2385 - 95 - H.F.W. Drilling 2415 -
6/27	Drly 2560 - H.F.W.
7/3	" 2770
7/11	" 2870
7/18	T.D. 2870 - u.R. 6"

7/15 - T.D. 2915 - Shut down
8/1 - Drlg 3070
8/7 - Drlg 3070 - top chat 3303
show gas 3310 - T.D. 3314 - UR 5"

8/15 - T.D. 3314 UR 5"

8/22 Top chat 3316
Drlg 3326

9/5 5# gas.
Top chat 3316

T.D. - 3358

7 1/3 # gas

850# Rock pr.

1930

11/12 - Top line 3302
Old T.D. 3358

drilled to
T.D. 3385

7# 3 # gas and
spraying oil

11/19 - S.D. 3385

11/25 - Top line 3302

Sand 3358-85

T.D. 3385

2 1/2 # gas

535# R.P.

Comp.

Summer

Map No. **KANSAS** Sec. *16* Twp. *35* R. *2* ^E

Well No. *1* *Mynes*
Fred Morgan et al Company
Contractor

COMPLETE

SECTION PLAT

..... Ft. from N. Line
330 Ft. from S. Line
..... Ft. from E. Line
330 Ft. from W. Line

Location.....

RECORD

Cased..... in., ft.
Sand *3358-3385*
Gas.....
Oil.....
Total Depth *3385*

PRODUCTION

1st 24 hrs. Nat.....
1st 24 hrs. after shot.....
Gas *2 1/2* *14* Cu. Ft.
Dry Hole.....
Abandoned.....

Drilling and Remarks:
Jap line 3302

535 # RP

Date *NOV 25 1930* **CHAS. L. SHERWOOD**
192..... Scout

Summer

Map No. **KANSAS** Sec. *16* Twp. *35* R. *2* ^E

Well No. *1* *Mynes*
Fred Morgan et al Company
Contractor

"Old well deeper"

SECTION PLAT

..... Ft. from N. Line
330 Ft. from S. Line
..... Ft. from E. Line
330 Ft. from W. Line

FIRST REPORTS

Location.....

RECORD

Cased..... in., ft.
Sand.....
Gas.....
Oil.....
Total Depth *3385*

Rig up.....

Drilling and Remarks:
Jap line 3302
old JD 3358
was deepened to
3385 making 3rd gas
and spraying oil.

PRODUCTION

1st 24 hrs. Nat.....
1st 24 hrs. after shot.....
Gas..... Cu. Ft.
Dry Hole.....
Abandoned.....

Date *NOV 12 1930* **CHAS. L. SHERWOOD**
192..... Scout

MAP No. **KANSAS** SEC. 16 TWP. 35 R. 2E

WELL No. 1 Mynes

Fred Morgan & Texas Oil COMPANY

CONTRACTOR

SECTION PLAT

_____ Ft. FROM N. LINE

450 Ft. FROM S. LINE

_____ Ft. FROM E. LINE

400 Ft. FROM W. LINE

COMPLETED

LOCATION _____

RIG UP _____

DRILLING AND REMARKS:

Top Chd 83316
Total Depth 8358

7/8 M. Gas
850th Rock PE

RECORD

CASED _____ IN. _____ FT.

SAND _____

GAS _____

OIL _____

TOTAL DEPTH _____

PRODUCTION

1ST 24 HRS. NAT. _____

1ST 24 HRS. AFTER SHOT _____

GAS _____ Cu. Ft.

DRY HOLE _____

ABANDONED _____

DATE

SEP 5 1928

S. J. LEWIS

192

SCOUT

MAP No. **KANSAS** SEC. 16 TWP. 35 R. 2E

WELL No. 1 Mynes

Fred Morgan & Texas Oil Company

Contractor

SECTION PLAT

_____ Ft. from N. Line

450 Ft. from S. Line

_____ Ft. from E. Line

400 Ft. from W. Line

FIRST REPORTS

Location _____

Rig up _____

Drilling and Remarks:

Spud
Machine
Gas test

RECORD

Cased _____ in., _____ ft.

Sand _____

Gas _____

Oil _____

Total Depth _____

PRODUCTION

1st 24 hrs. Nat. _____

1st 24 hrs. after shot _____

Gas _____ Cu. Ft.

Dry Hole _____

Abandoned _____

Date

MAR 7 1928

192

S. J. LEWIS

Scout