



Section 16 Township 35 Range 2 E
Well No. # 1 Wagner (Waggoner)
Company Aylward

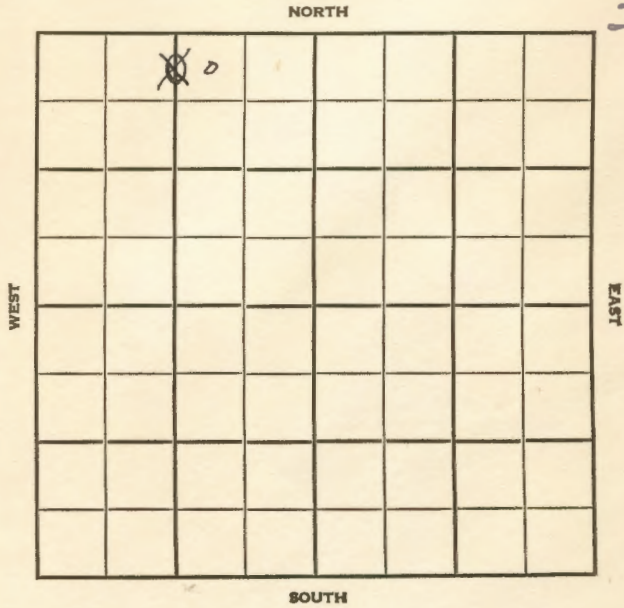

SEC. 16 TWP. 35 R. 2E
WELL NO. #1 Wagner FARM
COMPANY Aylward.
CONTRACTOR Co. Tools.

330 Ft. from N. Line
Ft. from S. Line
990 Ft. from E. Line
1320 Ft. from W. Line
NW NE
N₂ N₂ NW

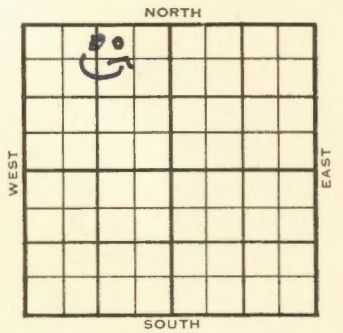

	ELEVATION	REPORT
1954	1109'	
11/3	Spud 11-1-54 8" @ 125' WOC.	
12/15	Spud 11-1-54 Oil well TD 3380 8" @ 125' Stal. 2289 DST 2288-2310 open 1 hr rec 40' mud 720# Layton 2675 DST 2676-2725 open 1 hr rec 530' Sw. 960# KC 2916 Cleve 3012 Bart 3334 Miss. 3349 DST 3349-69 open 1 hr rec 25' mud. 30# TD 3369 5" @ 3368 sd-oil-frac DD 3380 Comp. 25 BOPD	
COMPLETED		

County Summer State Kansas
 Sec. 16 (Blk. 35 (Sur. 2E) (Twp.) Rge.) Map No.
 Operator Aylward
 Well No. 1 Farm Wagner
 Elev. _____ Location C 1/2 N 1/2 NW

0			

330 Ft. From N Line NW
1320 Ft. From W Line Quarter
 Ist. Report NOV 3 1954
 Completion _____
 Remarks Co. tools
 Spudding Date 11-1-54

Drig. Data 8" @ 125 WOC

FABEN GILSTRAP

County Summer State Kansas
 Sec. 16 (Blk. 35 (Sur. 2E) (Twp.) Rge.) Map No.
 Operator Aylward Drig.
 Well No. 1 Farm Wagner
 Elev. 1109 Location NW NE NW

0			

330 Ft. From N Line NW
990 Ft. From E Line Quarter
 Ist. Report _____
 Completion DEC 15 1954
 Remarks Co. tools
 Spudding Date 11-1-54

Drig. Data Oil well TD 3380
8" @ 125 Stal. 2289 DST 2288-2310
open 1 hr. Rec. 40' mud 720#
Layton 2675 DST 2676-2725 open 1 hr.
Rec. 530' sw 960# KC 2916 Cleve. 3012
Bart. 3334 Miss. 3349 DST 3349-69
open 1 hr. Rec. 25' mud 30# TD 3369
5" @ 3368 sd-oil-frac DD 3380
Comp. 25 bopd

FABEN GILSTRAP

Map No. _____ Sec. 16 Twp. 35 R. 2E

Well No. 1 Wagner

Aylward Drlg. Company

CORRECTION Contractor

NW NE NW

SECTION PLAT

330 Ft. from N. Line

_____ Ft. from S. Line

990 Ft. from E. Line

_____ Ft. from W. Line

	0		

Sumner County

Location _____

Rig up _____

Drilling and Remarks:

Reported

C N $\frac{1}{2}$ N $\frac{1}{2}$ NW

RECORD

Cased _____ in., _____ ft.

Sand _____

Gas _____

Oil _____

Total Depth _____

PRODUCTION

1st 24 hrs. Nat. _____

1st 24 hrs. after shot _____

Gas _____ Cu. Ft.

Dry Hole _____

Abandoned _____

Date

NOV 10 1954

FABEN GILSTRAP Scout