


KANSAS

Section 16 Township 35 Range 2E
 Well No. #1 Waggoner
 Company E. B. Shawver
VERNON POOL
 NORTH

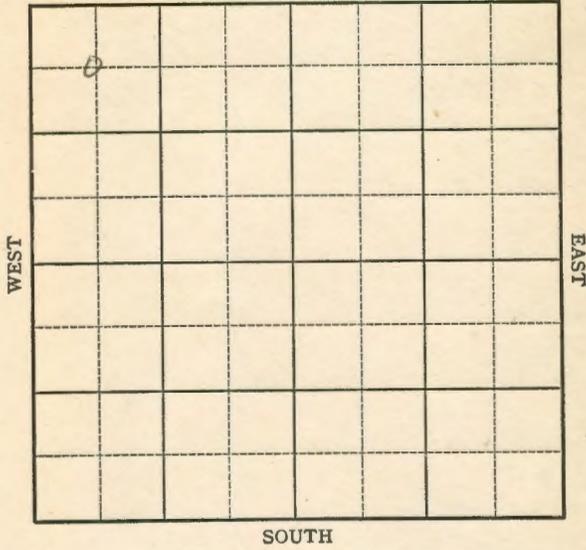


Summer KANSAS

Sec. 16 Twp. 35 R. 2-E
 Well No. #1 Waggoner Farm
E. B. Shawver Company

(Vernon Pool)

660 Ft. from N. Line
 _____ Ft. from S. Line
 _____ Ft. from E. Line
660 Ft. from W. Line

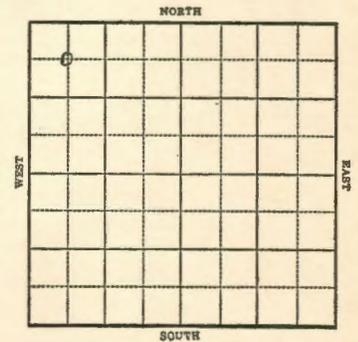

Elev. 1110

1942	REPORT
10/14	Location
10/21	10" @ 78' Drlg 786'
10/28	2805 Drlg.
11/11	5" @ 3331 Miss. 3328 T.D. 3380' 40 qts. 3360-80 Pump 20 Pot. Gravity 39
	COMPLETED

Map No. / Sec. 16 Twp. 35 R. 2E

Well No. 1 Waggoner
E. B. Shawver Company

COMPLETED Contractor

C NW NW

SECTION PLAT

660 Ft. from N. Line

Ft. from S. Line

Ft. from E. Line

660 Ft. from W. Line

o			

VERNON POOL

Location

Rig up

Drilling and Remarks:

Miss 3328
5" C 3331
40g to 3360-80
Pump 20 Pst.

39° G

RECORD

Cased in. ft.

Sand

Gas

Oil

Total Depth 3370

PRODUCTION

1st 24 hrs. Nat.

1st 24 hrs. after shot

Gas Cu. Ft.

Dry Hole

Abandoned

Date

NOV 11 1942

S. J. LEWIS Scout

Map No. / Sec. 16 Twp. 35 R. 2E

Well No. 1 Waggoner
E. B. Shawver Company

FIRST REPORT Contractor

C NW NW

SECTION PLAT

660 Ft. from N. Line

Ft. from S. Line

Ft. from E. Line

660 Ft. from W. Line

o			

VERNON POOL

Location XXX

Rig up

Drilling and Remarks:

RECORD

Cased in. ft.

Sand

Gas

Oil

Total Depth

PRODUCTION

1st 24 hrs. Nat.

1st 24 hrs. after shot

Gas Cu. Ft.

Dry Hole

Abandoned

Date

OCT 14 1942

S. J. LEWIS Scout