


Map No. KS Sec. 16 Twp. 35 R. 2 E
 Well No. 1- White Farm
Washona Company

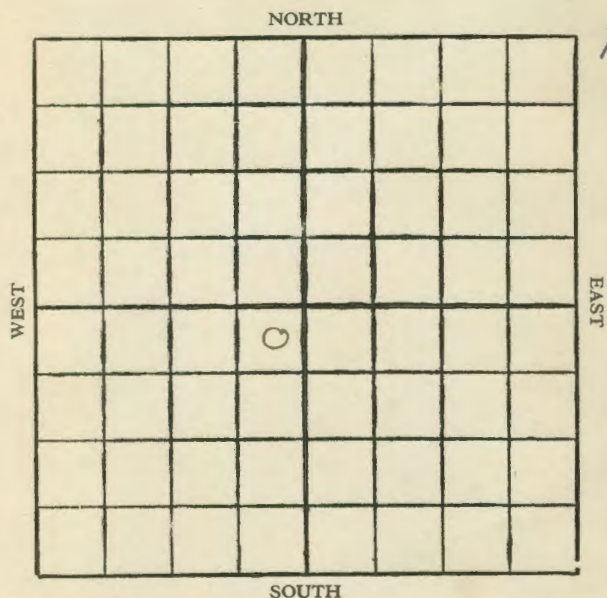

Location _____
 Drilling Remarks _____

Rig Up _____
 Drilling Remarks _____


RECORD

Cased _____ in. _____ ft.
 Sand _____
 Gas _____
 Oil _____
 Total Depth _____

PRODUCTION

1st 24 hrs. Nat. _____
 1st 24 hrs. after shot _____
 Gas _____ cu. ft.
 Dry Hole _____
 Abandoned _____

Map No. KS Sec. 16 Twp. 35 R. 2 E
 Well No. 1- white Farm
Washona Company

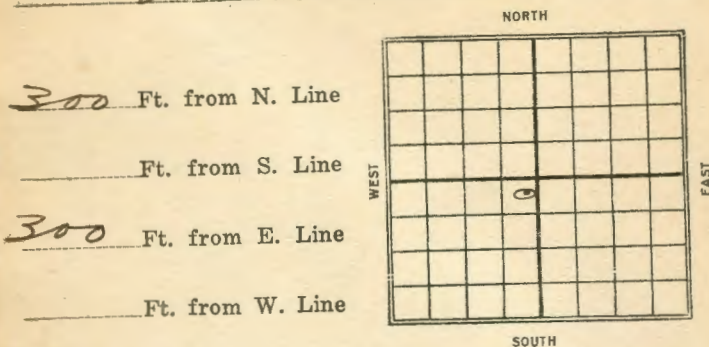

300 Ft. from N. Line

_____ Ft. from S. Line

300 Ft. from E. Line

_____ Ft. from W. Line

Date

REPORT

1926
12/1 Cellar
12/8 same
12/15 _____
12/21 _____
12/29 _____
1927
1/5 Rig
1/12 Rigging up
1/19 same
1/26 Spud 325
2/2 Drlg 720
2/9 " 910
2/16 " 1385
4/23 " 1680
3/2 no report
3/9 Drlg 2085
3/16 " 2150
3/23 T.D. 2150 - S.D.
3/30 T.D. 2750 - U.R. 8"
4/6 T.D. 2950 - U.R. 8"
4/13 Drlg 2985
4/20 no report
4/27 Top chak 3383 - 3399 Base
 Drilling 3485 -

5/4 - Top Waco 3577 - H.F. W.
T.D. 3583 - S.D. for orders -
5/11 - T.D. 3583 - S.D. for orders
5/18 - S. + A. 3583'

Map No. KANSAS Sec. 16 Twp. 35 R. 2EWell No. 1 WhiteWashona Company

Contractor

SECTION PLAT

300 Ft. from N. Line

Ft. from S. Line

300 Ft. from E. Line

Ft. from W. Line

ABANDONED

		0	

Location

Rig up

Drilling and Remarks:

TID 3583WHA

RECORD

Cased _____ in., _____ ft.

Sand _____

Gas _____

Oil _____

Total Depth _____

PRODUCTION

1st 24 hrs. Nat. _____

1st 24 hrs. after shot _____

Gas _____ Cu. Ft.

Dry Hole _____

Abandoned _____

Date

MAY 18 1927 102 S. J. LEWIS ScoutMap No. KANSAS Sec. 16 Twp. 35 R. 2EWell No. 1 WhiteWashona Company

Contractor

SECTION PLAT

300 Ft. from N. Line

Ft. from S. Line

300 Ft. from E. Line

Ft. from W. Line

		0	

FIRST REPORTS

Location

Rig up

Drilling and Remarks:

Cellar

RECORD

Cased _____ in., _____ ft.

Sand _____

Gas _____

Oil _____

Total Depth _____

PRODUCTION

1st 24 hrs. Nat. _____

1st 24 hrs. after shot _____

Gas _____ Cu. Ft.

Dry Hole _____

Abandoned _____

Date

DEC 1 - 1926 102 S. J. LEWIS Scout

MAP No. K1 KANSAS SEC. 16 TWP. 35S R. 2E

WELL No. 1 White
Washburn COMPANY

CONTRACTOR

SECTION PLAT

	0		

ABANDONED

_____ Ft. FROM N. LINE
_____ Ft. FROM S. LINE
_____ Ft. FROM E. LINE
_____ Ft. FROM W. LINE

LOCATION _____

RIG UP _____

DRILLING AND REMARKS:

3577 Sand
3583 H3.
0.42.

RECORD

CASED _____ IN. _____ FT.

SAND _____

GAS _____

OIL _____

TOTAL DEPTH 3583

PRODUCTION

1ST 24 HRS. NAT. _____

1ST 24 HRS. AFTER SHOT _____

GAS _____ Cu. Ft.

DRY HOLE ✓

ABANDONED ✓

DATE

5/17 1927 SCOUT