

KANSAS

SW 1/4 NE 1/4 NW 1/4
(NAD 83 KGS ORL 0002)

WELL COMPLETION REPORT AND
DRILLER'S LOG

API No. 15 — 099 — 21,208
County Number

S. 4 T. 35 R. 20 E
W
Loc. 400' FNL 900' FWL NE 1/4
County Labette

Operator
S & S Oil Company

Address
Box 304 Oswego, Ks. 67356


Well No. 8 Lease Name Schreppel

Footage Location 400' FNL 900' FWL
feet from (N) (S) line feet from (E) (W) line

Principal Contractor Blazer Drilling Company Geologist Bill Kardos

Spud Date 5-10-80 Date Completed 5-11-80 Total Depth 403' P.B.T.D. N/A

Directional Deviation None Oil and/or Gas Purchaser None

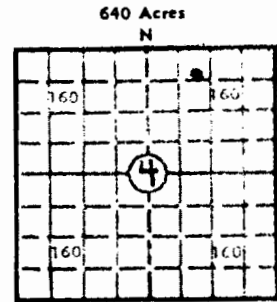

Locate well correctly
Elev.: Gr. 910'
DF _____ KB _____

CASING RECORD

Report of all strings set — surface, intermediate, production, etc.

| Purpose of string | Size hole drilled | Size casing set (in O.D.) | Weight lbs./ft. | Setting depth | Type cement | Sacks | Type and percent additives |
|-------------------|-------------------|---------------------------|-----------------|---------------|-------------|-------|----------------------------|
| Surface | 8 1/2 | 7" | 14 | 55' | Portland | 12 | None |
| Intermediate | 6 1/2 | 4 1/2 | 9 | 402' | Portland | 90 | None |
| | | | | | | | |
| | | | | | | | |

| LINER RECORD | | | PERFORATION RECORD | | |
|---------------|---------------|---------------|--------------------|-------------|----------------|
| Top, ft. | Bottom, ft. | Sacks cement | Shots per ft. | Size & type | Depth interval |
| | | | 1 | 1/2 | 326'-344' |
| TUBING RECORD | | | | | |
| Size | Setting depth | Pecker set at | | | |

ACID, FRACTURE, SHOT, CEMENT SQUEEZE RECORD

| Amount and kind of material used | Depth interval treated |
|----------------------------------|------------------------|
| None | |
| | |
| | |

INITIAL PRODUCTION

Date of first production None Producing method (flowing, pumping, gas lift, etc.)

| RATE OF PRODUCTION PER 24 HOURS | Oil | Gas | Water | Gas-oil ratio |
|--|-------|-----|------------------------|---------------|
| | bbls. | MCF | bbls. | CFPB |
| Disposition of gas (vented, used on lease or sold) | | | Producing interval (s) | |

INSTRUCTIONS: As provided in KCC Rule 82-2-125, within 90 days after completion of a well, one completed copy of this Drillers Log shall be transmitted to the State Geological Survey of Kansas, 4150 Monroe Street, Wichita, Kansas 67209. Copies of this form are available from the Conservation Division, State Corporation Commission, 245 No. Water, Wichita, Kansas 67202. Phone AC 316-522-2206. If confidential custody is desired, please note Rule 82-2-125. Drillers Logs will be an open file in the Oil and Gas Division, State Geological Survey of Kansas, Lawrence, Kansas 66044.

