

**WELL COMPLETION REPORT AND DRILLER'S LOG**

S. 6 T. 35 R. 20 E  
 Loc. 680' FSL 200' FEL N/2' NW  
 SE NE NE NW  
 County LABETTE

API No. 15 — 099 — 21,078  
 County Number

Operator  
S & S Oil Co.

Address  
Box 304, Oswego, KS 67356


Well No. 3 Lease Name Jack V. Foley *KCC Record*

Footage Location 680' FSL 4640 FSL 2840 FEL 200' FEL  
 feet from (N) (S) line feet from (E) (W) line

Principal Contractor Nance Drilling Company Geologist Bill Kardos

Spud Date 12-20-79 Date Completed 2-15-80 Total Depth 967 1/2' P.B.T.D. N/A

Directional Deviation None Oil and/or Gas Purchaser Koch Oil Company

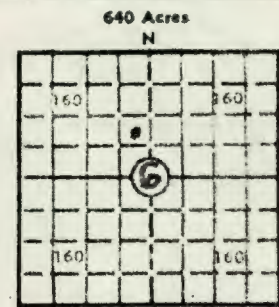

Locate well correctly  
 Elev.: Gr. 906'  
 DF \_\_\_\_\_ KB \_\_\_\_\_

**CASING RECORD**

Report of all strings set — surface, intermediate, production, etc.

Purpose of string	Size hole drilled	Size casing set (in O.D.)	Weight lbs./ft.	Setting depth	Type cement	Sacks	Type and percent additives
Surface	8 1/2"	7"	14	55'	Portland	12	None
Intermediate	6 1/2"	4 1/2"	9	963'	Portland	95	None

**LINER RECORD**

**PERFORATION RECORD**

Top, ft.	Bottom, ft.	Sacks cement	Shots per ft.	Size & type	Depth interval

**TUBING RECORD**

Size	Setting depth	Packer set at

**ACID, FRACTURE, SHOT, CEMENT SQUEEZE RECORD**

Amount and kind of material used	Depth interval treated
None-Packer shoe drilled out.	

**INITIAL PRODUCTION**

Date of first production <u>2-18-80</u>	Producing method (flowing, pumping, gas lift, etc.) <u>Pumping</u>
RATE OF PRODUCTION PER 24 HOURS	Oil <u>12</u> bbls. Gas <u>None</u> MCF Water <u>60</u> bbls. Gas-oil ratio <u>CFPB</u>
Disposition of gas (vented, used on lease or sold)	Producing interval (s) <u>965' - 967 1/2'</u>

INSTRUCTIONS: As provided in KCC Rule 82-2-125, within 90 days after completion of a well, one completed copy of this Drillers Log shall be transmitted to the State Geological Survey of Kansas, 4150 Monroe Street, Wichita, Kansas 67209. Copies of this form are available from the Conservation Division, State Corporation Commission, 245 No. Water, Wichita, Kansas 67202. Phone AC 316-522-2206. If confidential custody is desired, please note Rule 82-2-125. Drillers Logs will be on an open file in the Oil and Gas Division, State Geological Survey of Kansas, Lawrence, Kansas 66044.

Operator S & S Oil Company		DESIGNATE TYPE OF COMP.: OIL, GAS, DRY HOLE, SWDW, ETC.:
Well No. 3	Lease Name Jack Foley	Oil
S 6 T 35 R 20 E		


### WELL LOG

Show all important zones of porosity and contents thereof; cored intervals, and all drill-stem tests, including depth interval tested, cushion used, time tool open, flowing and shut-in pressures, and recoveries.

SHOW GEOLOGICAL MARKERS, LOGS RUN, OR OTHER DESCRIPTIVE INFORMATION.

FORMATION DESCRIPTION, CONTENTS, ETC.	TOP	BOTTOM	NAME	DEPTH

USE ADDITIONAL SHEETS, IF NECESSARY, TO COMPLETE WELL RECORD.

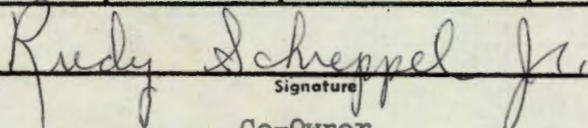Date Received	<div style="text-align: center;">             Signature            Co-Owner            Title            11-18-80            Date         </div>
---------------	---

