

WELL COMPLETION REPORT AND
DRILLER'S LOG

S. 9 T. 35 R. 20 ^E ~~XX~~

Loc. 700° FNL 840° FEL NE $\frac{1}{4}$

API No. 15 — 099 — 20,993
County Number

County Labette

Operator
S & S Oil Company

Address
Box 304 Oswego, Ks. 67356


Well No. 5 Lease Name Marie Olson

Footage Location 700° F.N.L. 840° F.E.L.
feet from (N) (S) line feet from (E) (W) line

Principal Contractor Nance Drilling Company Geologist Bill Kardos

Spud Date 9-29-79 Date Completed 10-8-79 Total Depth 610' P.B.T.D. N/A

Directional Deviation None Oil and/or Gas Purchaser Cities Service Gas Co.

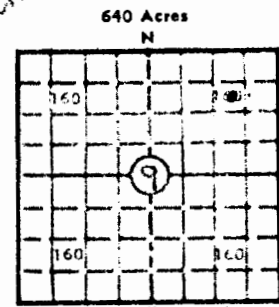

Locate well correctly
Elev.: Gr. 906'
DF _____ KB _____

CASING RECORD

Report of all strings set — surface, intermediate, production, etc.

Purpose of string	Size hole drilled	Size casing set (in O.D.)	Weight lbs/ft.	Setting depth	Type cement	Socks	Type and percent additives
Surface	8 1/2	7"	14	55°	Portland	10	None
Production Gas	6 1/2	2 3/8	7 1/2	610°	Portland	105	None

LINER RECORD

PERFORATION RECORD

Top, ft.	Bottom, ft.	Socks cement	Shots per ft.	Size & type	Depth interval
			1	1/2	585°-610°

Size	Setting depth	Packer set at

ACID, FRACTURE, SHOT, CEMENT SQUEEZE RECORD

Amount and kind of material used	Depth interval treated
150 Gals. 15%	585°-610°

INITIAL PRODUCTION

Date of first production None Shut-In Producing method (flowing, pumping, gas lift, etc.)

RATE OF PRODUCTION PER 24 HOURS	Oil	Gas	Water	Gas-oil ratio
	bbls.	MCF	bbls.	CFPB
Disposition of gas (vented, used on lease or sold)			Producing interval(s)	

INSTRUCTIONS: As provided in KCC Rule 82-2-125, within 90 days after completion of a well, one completed copy of this Drillers Log shall be transmitted to the State Geological Survey of Kansas, 4150 Monroe Street, Wichita, Kansas 67209. Copies of this form are available from the Conservation Division, State Corporation Commission, 245 No. Water, Wichita, Kansas 67202. Phone AC 316-522-2206. If confidential custody is desired, please note Rule 82-2-125. Drillers Logs will be an open file in the Oil and Gas Division, State Geological Survey of Kansas, Lawrence, Kansas 66044.

Operator S & S Oil Company		DESIGNATE TYPE OF COMP.: OIL, GAS, DRY HOLE, SWDW, ETC.:
Well No. 5	Lease Name Marie Olson	Gas
S 9 T 35 R 20 E XX		

WELL LOG

Show all important zones of porosity and contents thereof; cored intervals, and all drill-stem tests, including depth interval tested, cushion used, time tool open, flowing and shut-in pressures, and recoveries.

SHOW GEOLOGICAL MARKERS, LOGS RUN, OR OTHER DESCRIPTIVE INFORMATION.

FORMATION DESCRIPTION, CONTENTS, ETC.	TOP	BOTTOM	NAME	DEPTH
Overburden	0	3		
Lime	3	31		
Black shale	31	35		
Lime	35	62		
Black shale	62	66		
Lime	66	70		
Sandy lime	70	74		
Gray sandy shale	74	106		
Dark gray shale	106	157		
Lime	157	161		
Dark gray shale streaks of lime	161	282		
Gray sandy shale	282	310		
Dark gray shale	310	324		
Dark gray sand	324	326		
Gray sandy shale	326	382		
Gray sand gas	382	391	Barts.	
Dark gray sand	391	393		
Lime	393	394		
Dark gray shale	394	585		
		585	Top Miss.	
Lime gray sandy lime	585	610		
		610	T.D.	

USE ADDITIONAL SHEETS, IF NECESSARY, TO COMPLETE WELL RECORD.

Date Received	<i>Rudy Schreppel Jr.</i> Signature
	Co-Owner Title
	11-18-80 Date