


Section 14 Township 35 Range 3E
Well No. #2 Rippe
Company L.C. Smitherman

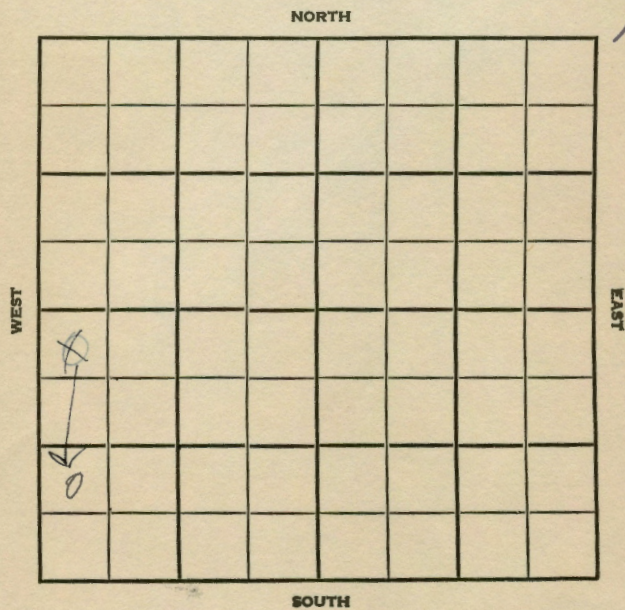

CORRECTION

County Cowley Elev. 1134 DF
 Sec. 14 Twp. 34-35 Rge. 3E
 Company L.C. Smitherman
 FarmName Rippe No. 2

TOPS	DEPTH	LOG	DATUM	Loc. in Sec.
Anh.				
T.P. <u>Stall</u>	<u>2255</u>			<u>NW NW SW</u>
H. <u>Lay</u>	<u>2698</u>			<u>SW</u>
Tr.				
Dg.				
BL. <u>Part 13d</u>	<u>3447-58</u>			
L.				
K.C.				Geol.
B.K.C.				Contr.
Ce.				
C.				
M.				
M.				Pool
K.				<u>Rippe</u>
Mz.				
Me.				
V.				
S.				
S.				
A.				
R.				
Pe.				
G.				
T.D.				

ABANDONED

MAR 27 57

Date Comm.

Celler & Pits DEC 5 '56 C.E.P. DEC 12 '56

DEC 19 '56 ✓ DEC 26 '56 ✓ JAN 2 '57 ✓

JAN 9 '57 JAN 16 '57 JAN 23 '57 JAN 30 '57

FEB 6 '57 ✓ FEB 13 '57 FEB 20 '57 FEB 27 '57 ✓

MAR 6 '57 2-28-57 10 3/4 97/100

APR 20 '57 TD 3470 MAR 20 '57

APR 27 '57

D & A

County Cowley Elev. 1134 DF
 Sec. 14 Twp. 34-35 Rge. 3E
 Company L.C. Smitherman
 FarmName Rippe No. 2

TOPS	DEPTH	LOG	DATUM	Loc. in Sec.
Anh.				
T.P.				<u>NW NW SW</u>
H.				
Tr.				
Dg.				
BL.				
L.				Geol.
K.C.				Contr.
B.K.C.				
Ce.				
C.				
M.				
M.				Pool
K.				<u>Rippe</u>
Mz.				
Me.				
V.				
S.				
S.				
A.				
R.				
Pe.				
G.				
T.D.				

FIRST REPORT

Date Comm.

Celler & Pits

29