Range 7 E

Township 35 S

Section 8

County Cowley

Farm Lemaster No. 4

Company —

Sec

Twp

6	5	4	3	2	1
7	X	9	10	11	12
18	17	16	15	14	13
19	20	21	22	23	24
30	29	28	27	26	25
31	32	33	34	35	36

CSL $\overset{ø}{\text{SE}}$ SE

Elev. ±1180 T.D. 3070

Date Drilled 7-30-19

Correlation by

Prod- Dry

0 🟦 soil

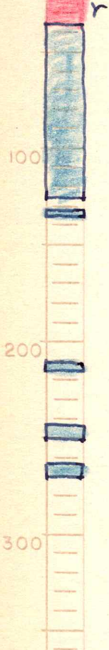
r
100
200
300

12½" – 65'

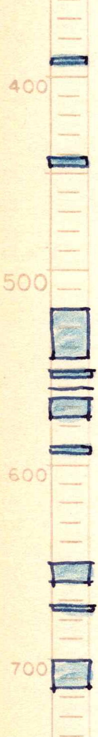
400
500
600
700

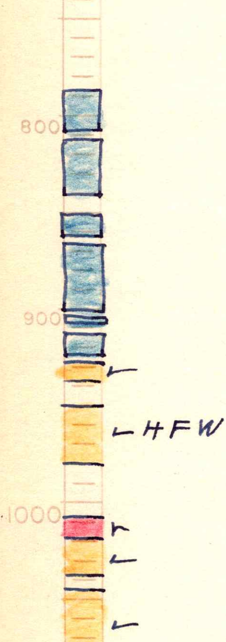
800
900
1000
HFW

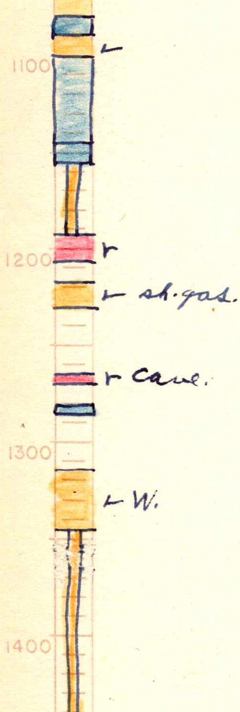
1100
1200
r
sh. gas.
r Cave.
1300
W.
1400

10" – 1359'

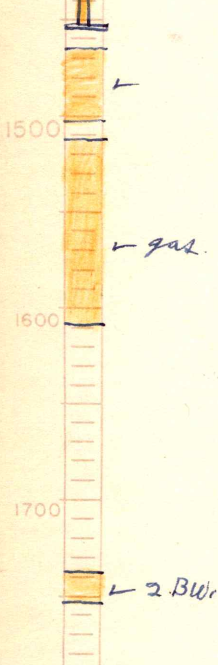
1500
gas
1600
1700
2 BW.

8¼" – 1616'

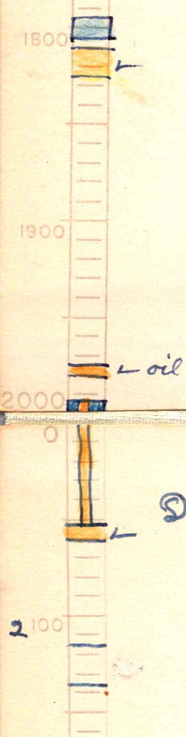
1800
1900
oil
2000
0
2 100

$6\frac{5}{8}''$ – 1985

Deepening Record.
11-27-20

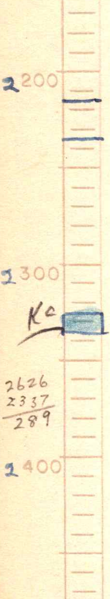
2200
2300
Ka
2400

$6\frac{5}{8}$" - 2248'

2626
2337
289

2337

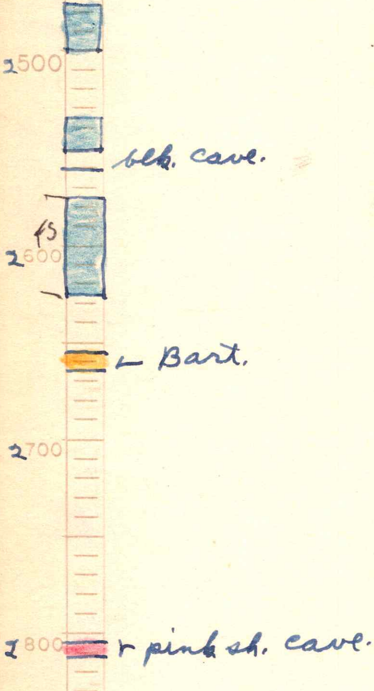
2500
blk. cave.
fs
2600
Bart.
2700
2800
pink sh. cave.

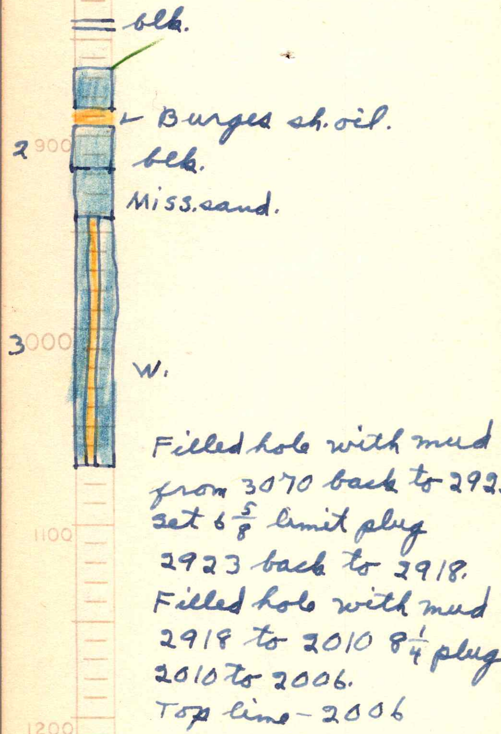
blk.
Burges sh. oil.
2900
blk.
Miss. sand.
3000
W.
1100
1200

Filled hole with mud
from 3070 back to 2923,
set $6\frac{5}{8}$ limit plug
2923 back to 2918.
Filled hole with mud
2918 to 2010 $8\frac{1}{4}$ plug
2010 to 2006.
Top line - 2006

8¼ packers · 2006-1801

P. B. - 1984.

1300

T. D. - 3070'

1400

1500

1600

1700

1800

1900

2000