


Marshall

Form 51-5M-4-27-27423

Map No. **KANSAS** Sec. 10 Twp. 3 R. 7E

Well No. 1-1000 Farm  
Erwin Bros. Company

NORTH

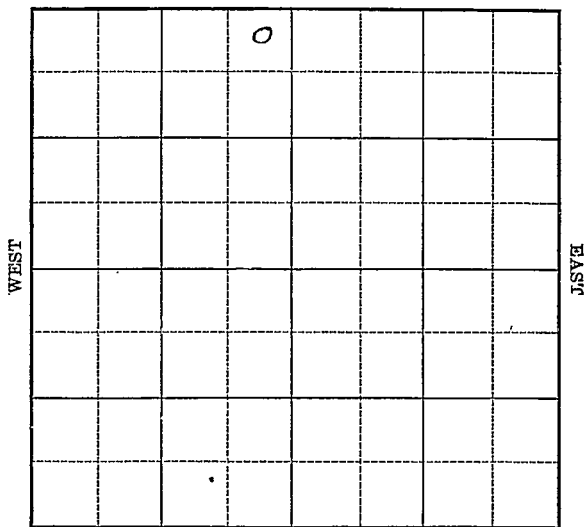

SOUTH

Location \_\_\_\_\_

Drilling Remarks

Rig Up \_\_\_\_\_

Drilling Remarks

RECORD

Cased \_\_\_\_\_ in. \_\_\_\_\_ ft.

Sand \_\_\_\_\_

Gas \_\_\_\_\_

Oil \_\_\_\_\_

Total Depth \_\_\_\_\_

PRODUCTION

1st 24 hrs. Nat. \_\_\_\_\_

1st 24 hrs. after shot \_\_\_\_\_

Gas \_\_\_\_\_ cu. ft.

Dry Hole \_\_\_\_\_

Abandoned \_\_\_\_\_


Map No. KANSAS Sec. 10 Twp. 3 R. 7 E  
Well No. J - Cooper Farm,  
Corwin Bros Company,

250 Ft. from N. Line

\_\_\_\_\_ Ft. from S. Line

250 Ft. from E. Line

\_\_\_\_\_ Ft. from W. Line

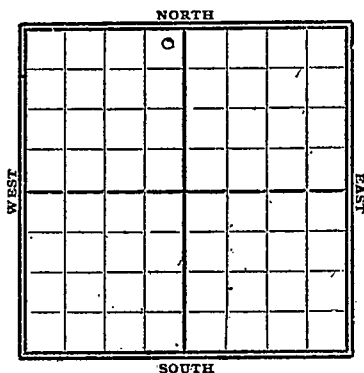

1928

| Date  | REPORT      |
|-------|-------------|
| 10/3  | Spdy & S.D. |
| 10/10 | _____       |
| 10/17 | _____       |
| 10/24 | _____       |
| 10/31 | _____       |
| 11/7  | _____       |
| 11/14 | _____       |
| 11/21 | _____       |
| 11/28 | _____       |
| 12/5  | _____       |
| 12/12 | _____       |
| 12/19 | _____       |
| 12/26 | _____       |
| 1929  |             |
| 1/2   | _____       |
| 1/9   | drlg 800'   |
| 1/16  | " 800'      |
| 1/23  | " 800'      |
| 1/30  | " 800'      |
| 2/6   | S.D. 800'   |
| 2/13  | _____       |
| 2/20  | _____       |

2/27- SD. 800'  
3/6 —  
3/13- Drlg 1560'  
3/19- sltly 6"-1600'  
3/27 —  
4/3 —  
4/9 —  
4/16- SD. 1600'  
4/23 —  
5/11 —  
5/18 —  
5/15 —  
5/22- drlg 2020'  
5/29- " 2020'  
6/5 —  
6/12- No report  
6/19- Top line 2025'  
show oil 2025-30'  
Chat 2045-65- HFW  
Base line 2240'  
T.D. 2280'-SD. for 5"  
6/26 —  
7/2 —  
7/10 —  
7/17 —  
7/24 —  
7/31 —  
8/7 —  
8/14 —  
8/21- Top line 2025-2240'  
TD 2515'  
Dry & Abandoned

MAP NO.

KANSAS

SEC.

10

TWP.

3

R.

7

E

WELL NO.

Cotton

Cooper

Blair

COMPANY

CONTRACTOR

## FIRST REPORTS

## SECTION PLAT

|  |   |  |  |
|--|---|--|--|
|  | 0 |  |  |
|  |   |  |  |
|  |   |  |  |
|  |   |  |  |
|  |   |  |  |

LOCATION

RIG UP

DRILLING AND REMARKS:

## RECORD

CASED \_\_\_\_\_ IN. \_\_\_\_\_ FT.

SAND \_\_\_\_\_

GAS \_\_\_\_\_

OIL \_\_\_\_\_

TOTAL DEPTH \_\_\_\_\_

## PRODUCTION

1ST 24 HRS. NAT. \_\_\_\_\_

1ST 24 HRS. AFTER SHOT \_\_\_\_\_

GAS \_\_\_\_\_ CU. FT.

DRY HOLE \_\_\_\_\_

ABANDONED \_\_\_\_\_

DATE

OCT 3

1928

CHAS. L. SHERWOOD

1928

SCOUT

no drawing  
no wall map

|                       |             |
|-----------------------|-------------|
| Returned              |             |
| Cards                 | <i>Kut</i>  |
| Tracing               | <i>None</i> |
| France Map            |             |
| Scarborough Map       | <i>X</i>    |
| Moody Map             |             |
| Scarborough Plat Book |             |
| Moody Plat Book       |             |

*Marchess*

Map No. **KANSAS** Sec. *10* Twp. *3* R. *7*

Well No. *1* *Cooper*

*Erwin Bros* Company

Contractor

**COMPLETE****SECTION PLAT**

|  |          |  |  |
|--|----------|--|--|
|  | <i>0</i> |  |  |
|  |          |  |  |
|  |          |  |  |
|  |          |  |  |

*750* Ft. from N. Line

Ft. from S. Line

*750* Ft. from E. Line

Ft. from W. Line

**ABANDONED**

Location \_\_\_\_\_

Rig up \_\_\_\_\_

Drilling and Remarks:

*T. line 2025-2740***RECORD**

Cased \_\_\_\_\_ in., \_\_\_\_\_ ft.

Sand \_\_\_\_\_

Gas \_\_\_\_\_

Oil \_\_\_\_\_

Total Depth *2515***PRODUCTION**

1st 24 hrs. Nat. \_\_\_\_\_

1st 24 hrs. after shot \_\_\_\_\_

Gas \_\_\_\_\_ Cu. Ft.

Dry Hole ☒Abandoned ☒



Date

*8/21*19 *29***CHAS. L. SHERWOOD**

Scout

2427437

no small ring  
no woe
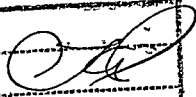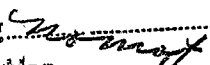
|                       |                                                                                     |
|-----------------------|-------------------------------------------------------------------------------------|
| Returned              |  |
| Cards                 |                                                                                     |
| Tracing               |  |
| France Map            |                                                                                     |
| Scarborough Map       |  |
| Mordy Map             |                                                                                     |
| Scarborough Plot Book |                                                                                     |
| Moody Plot Book       |                                                                                     |