


Section 11 Township 3 Range 14 E

Well No. # 1 H. L. Hook

Company Skelly Oil

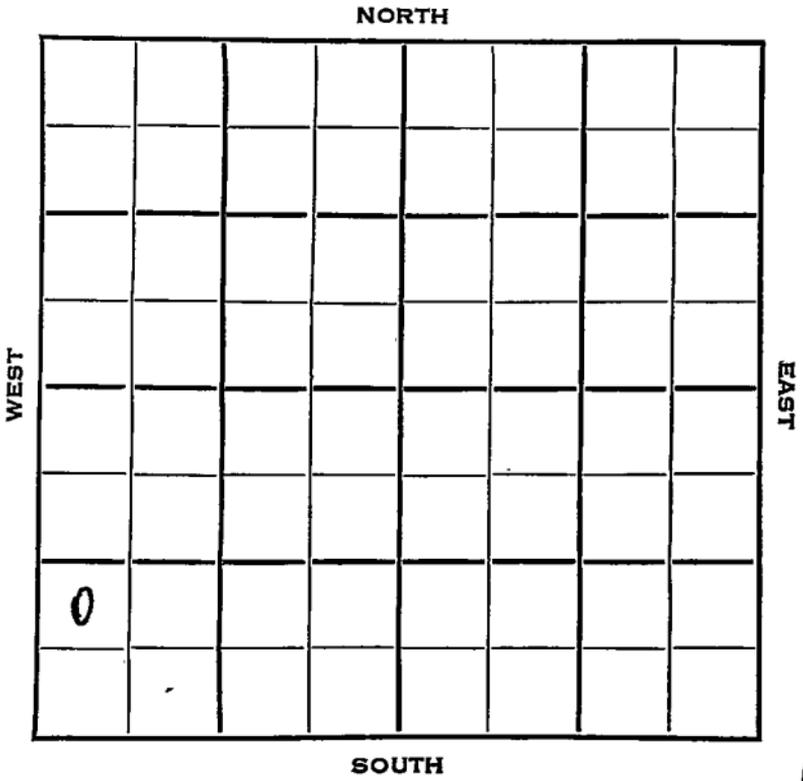

13

Nemaha

KANSAS

SEC.	TWP.	R.
11	3	11E ✓

WELL NO.

#1 H.L. Hook

FARM

COMPANY

Skelly Oil

CONTRACTOR

Wildcat

Ft. from N. Line


990

Ft. from S. Line

Ft. from E. Line

330

Ft. from W. Line

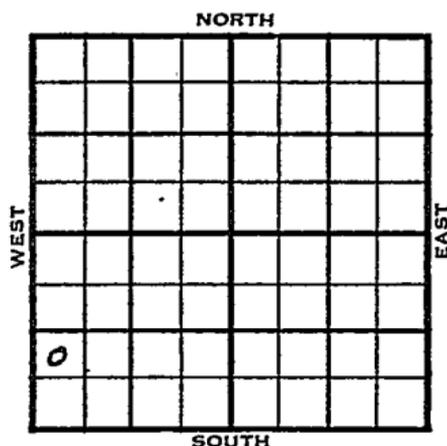

NW SW SW

ELEVATION

REPORT

1953

- 1254

10/21

Location
Core Drill

11/18

Spud 10-23-53

D & A

TD 3716'

8" @ 154'

Howard 789', Top 832', Lans 1275',

KC 1366', Cherokee 1797', Miss 2492'

Kh. 2682, Hunton 2920',

DST 2923'-35' opn 1 hr, rec 6' Mud,
980#

DST 2930'-44' opn 1 hr, rec 39' hocm

1' oil 800# Maq 3557', Viola 3620'

TD 3716'

lost circ.

D & A

ABANDONED

