

15013000030000

FORM 51 25M 3-49 PETROL

Brown **KANSAS**

Section 11 Township 3 Range 16E

Well No. #1 Georson

Company National Assoc. Pet.

Wildcat

NORTH

0							

WEST

EAST

SOUTH

13

Brown

KANSAS

Sec. 11 Twp. 3 R. 16E

Well No. #1 Georson Farm

National Assoc. Pet. Company

Wildcat (Pabco, Contr NORTH)

Ft. from N. Line


330'

Ft. from S. Line

Ft. from E. Line

330' Ft. from W. Line

SW/C

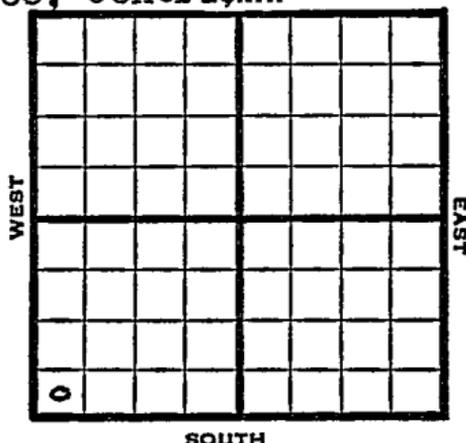

1949 1160 REPORT

11/30 Location
12/7 "
12/14 "
12/21 8" @ 207'
12/28 Lansing 1046'
Drlg 2530'
1950
1/4 TD 3433'
8" @ 207'
Lans 1044'
Heward 517'
Topeka 615'
KC 1146'
BKC 1374'
Miss 2343'
King 2586'
Hunton 2810'
Maquakta 3314'
Viola 3405'
No shows
D&A
Aband.

1374
1160

-214

ABANDONED

Kansas

Map No. _____ Sec. 11 Twp. 3 R. 16E

Well No. 1 Goerson

National Assoc. Pet. _____ Company

Contractor _____

SW/C


SECTION PLAT

_____ Ft. from N. Line

330 Ft. from S. Line

_____ Ft. from E. Line

330 Ft. from W. Line

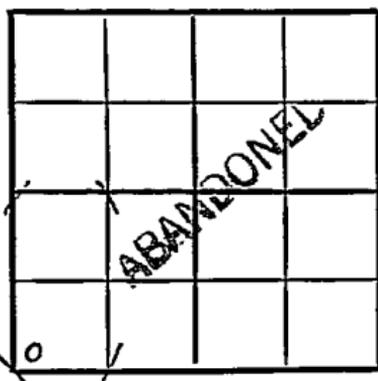

Brown County

RECORD

Location _____

Cased _____ in., _____ ft.

Rig up _____

Sand _____

Drilling and Remarks:

Gas _____

Oil _____

Total Depth 3433

8" @ 207
 Lans. 1044
 Howard 517
 Sopka 615
 K.C. 1146
 BKC 1374
 Miss 2343
 Kind. 2586
 Hurton 2810

PRODUCTION

1st 24 hrs. Nat. _____

1st 24 hrs. after shot _____

Gas _____ Cu. Ft.

Dry Hole _____

Abandoned _____

Maquoketa 3314

Wield 3405

Date no show

S+A

JAN 4 1950 19 _____

J. E. Lyra Scout

Map No. _____ Sec. 11 Twp. 3 R. 16E

Well No. 1 Georson

_____ National Assoc. Pet. _____ Company

_____ Pabco _____ Contractor

SW/C

~~FIRST REPORT~~

SECTION PLAT

_____ Ft. from N. Line

330

_____ Ft. from S. Line

_____ Ft. from E. Line

330

_____ Ft. from W. Line

Brown County

Location X

Rig up _____

Drilling and Remarks:

RECORD

Cased _____ in., _____ ft.

Sand _____

Gas _____

Oil _____

Total Depth _____

PRODUCTION

1st 24 hrs. Nat. _____

1st 24 hrs. after shot _____

Gas _____ Cu. Ft.

Dry Hole _____

Abandoned _____

Date

NOV 30 1949

19

S. J. LEWIS

Scout