

15131000110000

FORM 51 10M 2-49 PETROL

KANSAS

Nemaha


Section 13 Township 3 Range 14E

Well No. 1 Draney Heirs

Company Carter

Wildcat

NORTH

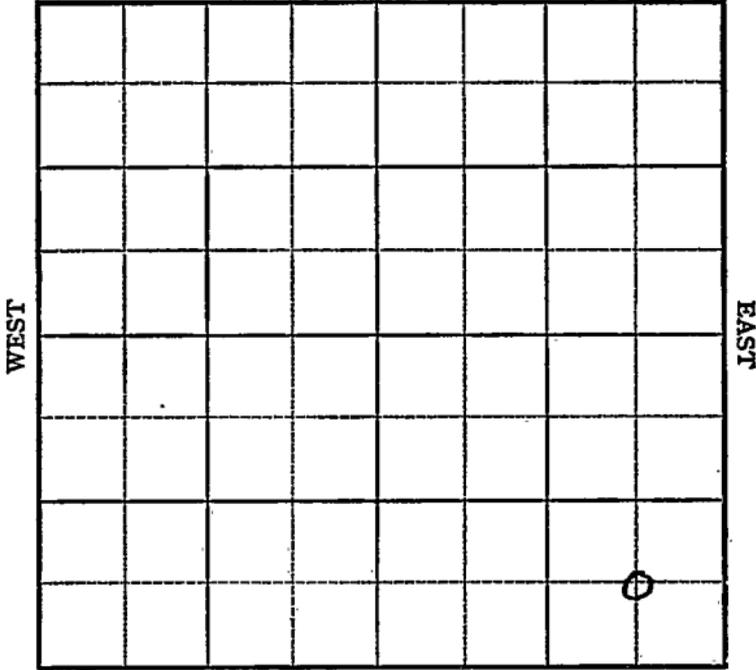

SOUTH

16



Sec. 13 Twp. 3 R. 14E

Well No. #1 Draney Heirs Farm

Carter Company


Wildcat

_____ Ft. from N. Line

660' Ft. from S. Line

660' Ft. from E. Line

_____ Ft. from W. Line

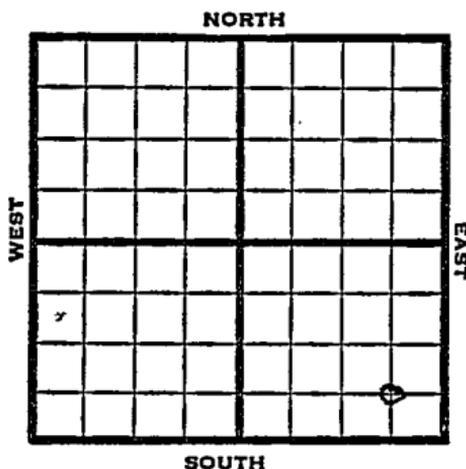

C SE SE

Elev 1251' REPORT

1949

- 2/16 Location
- 2/23 " "
- 3/2 Drlg 85'
- 3/8 10" @ 138'
- Howard 806'
- Topeka 836'
- KC 1308'?
- Drlg 1532'
- 3/16 BKG 1661'
- Miss 2637'
- Drlg 2643'
- 3/23 TD 3152'
- Hunton 3178'
- Aband.

3178
1251
-1927

ABANDONED

Kansas

Map No. _____ Sec. 13 Twp. 3 R. 14E

Well No. 1 Draney Heirs

Carter Company

FIRST REPORT Contractor

C SE SE

SECTION PLAT

_____ Ft. from N. Line

660 Ft. from S. Line

660 Ft. from E. Line

_____ Ft. from W. Line

			3

Nemaha County

Location X

Rig up _____

Drilling and Remarks:

RECORD

Cased _____ in., _____ ft.

Sand _____

Gas _____

Oil _____

Total Depth _____

PRODUCTION

1st 24 hrs. Nat. _____

1st 24 hrs. after shot _____

Gas _____ Cu. Ft.

Dry Hole _____

Abandoned _____

Date

FEB 16 1949 19

S. J. LEWIS Scout

Map No. 122 Sec. 13 Twp. 3 R. 14E

Well No. 1 Draney Heirs

Carter Company

ABANDONED

Contractor

C SE SE

E. 1251
SECTION PLAT

_____ Ft. from N. Line

660 Ft. from S. Line

660 Ft. from E. Line

_____ Ft. from W. Line

			o

Nemaha County

RECORD

Location _____

Cased _____ in., _____ ft.

Rig up _____

Sand _____

Drilling and Remarks:

Gas _____

Oil _____

Total Depth 3152

Hunter 3178

PRODUCTION

1st 24 hrs. Nat. _____

1st 24 hrs. after shot _____

Gas _____ Cu. Ft.

Dry Hole _____

Abandoned _____

Date

MAR 23 1949

19

S. J. LEWIS Scout