

STATE CORPORATION COMMISSION OF KANSAS  
OIL & GAS CONSERVATION DIVISION  
WELL COMPLETION OR RECOMPLETION FORM  
ACO-1 WELL HISTORY  
DESCRIPTION OF WELL AND LEASE

Operator: License # 9104  
Name Ematron Oil, Inc.  
Address Box 286  
City/State/Zip Albion, Neb.

Purchaser NA

Operator Contact Person Gene Murphy  
Phone (402) 395-2344

Contractor: License # 5146  
Name Rains and Williamson

Wellsite Geologist Paul Prijatel  
Phone (719) 544-2111

Designate Type of Completion

New Well  Re-Entry  Workover  
 Oil  SWD  Temp Abd  
 Gas  Inj  Delayed Comp.  
 Dry  Other (Core, Water Supply etc.)

If **OWWO**: old well info as follows:

Operator  
Well Name  
Comp. Date Old Total Depth

RECEIVED

STATE CORPORATION COMMISSION

Drilling Method:

Mud Rotary  Air Rotary  Cable

8/30/88 9/6/88 NA 7-6:88  
Spud Date Date Reached TD Completion Date

4105  
Total Depth PBD

Amount of Surface Pipe Set and Cemented at 372 feet  
Multiple Stage Cementing Collar Used? Yes  No  
If yes, show depth set feet  
If alternate 2 completion, cement circulated from feet depth to w/ SX cmt  
Cement Company Name B.J. Titan Services  
Invoice #

API NO. 15-131-20142  
County Nemaha  
NW NW SE  
Sec 9 Twp 3S Rge 14 East  West

2310 Ft North from Southeast Corner of Section  
2310 Ft West from Southeast Corner of Section  
(Note: Locate well in section plat below)


Lease Name Meyer Well # 1

Field Name NA

Producing Formation NA

Elevation: Ground 1320' 1325' KB

Section Plat

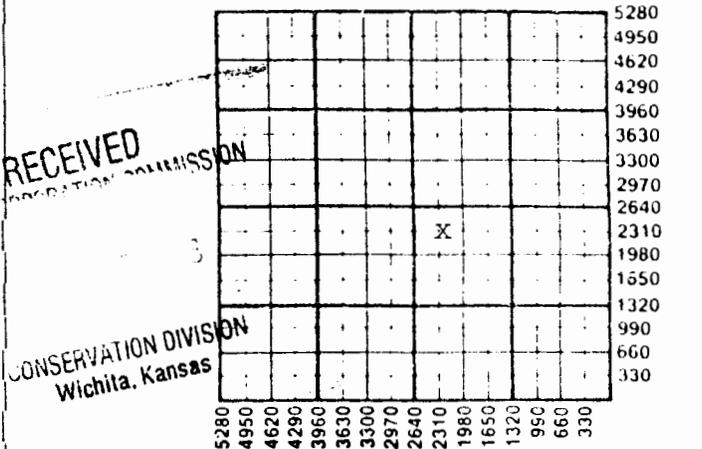

RECEIVED  
STATE CORPORATION COMMISSION  
CONSERVATION DIVISION  
Wichita, Kansas

WATER SUPPLY INFORMATION

Disposition of Produced Water:  Disposal  Repressuring  
Docket #

Questions on this portion of the ACO-1 call:  
Water Resources Board (913) 296-3717

Source of Water:  
Division of Water Resources Permit #

Groundwater 4620 Ft North from Southeast Corner  
(Well) 4620 Ft West from Southeast Corner of  
Sec 15 Twp 3S Rge 14 East West

Surface Water Ft North from Southeast Corner  
(Stream, pond etc) Ft West from Southeast Corner  
Sec Twp Rge East West

Other (explain)  
(purchased from city, R.W.D. #)

INSTRUCTIONS: This form shall be completed in triplicate and filed with the Kansas Corporation Commission, 200 Colorado Derby Building, Wichita, Kansas 67202, within 120 days of the spud date of any well. Rule 82-3-130, 82-3-107 and 82-3-106 apply. Information on side two of this form will be held confidential for a period of 12 months if requested in writing and submitted with the form. See rule 82-3-107 for confidentiality in excess of 12 months. One copy of all wireline logs and drillers time log shall be attached with this form. Submit CP-4 form with all plugged wells. Submit CP-111 form with all temporarily abandoned wells.

All requirements of the statutes, rules and regulations promulgated to regulate the oil and gas industry have been fully complied with and the statements herein are complete and correct to the best of my knowledge.

Signature [Signature]  
Title Geologist Date 10/3/88

Subscribed and sworn to before me this 14th day of October 1988  
Notary Public [Signature]  
Date Commission Expires 1/1/91

K.C.C. OFFICE USE ONLY  
 Letter of Confidentiality Attached  
 Wireline Log Received  
 Drillers Time Log Received  
Distribution  
 KCC  SWD/Rep  NGPA  
 KGS  Plug  Other (Specify)

OCT 13 1988

KANSAS CORPORATION COMMISSION

Sec 9, Twp 3S, Rge 14E