

5

STATE CORPORATION COMMISSION OF KANSAS
OIL & GAS CONSERVATION DIVISION
WELL COMPLETION OR RECOMPLETION FORM
ACO-1 WELL HISTORY
DESCRIPTION OF WELL AND LEASE

Operator: License # 6101 and 9116
Name Teichgraeber Oil/Brown Energy
Address P.O. Box 471
635 Metcalf Road
City/State/Zip Ft. Dorado, KS 67042

Purchaser N/A

Operator Contact Person R. K. Teichgraeber
Phone 316-321-2770

Contractor: License # 5676
Name EDCO Drilling Company, Inc.

Wellsite Geologist Dennis T. Hedke
Phone 316-685-1336

Designate Type of Completion
 New Well Re-Entry Workover
 Oil SWD Temp Abd
 Gas Inj Delayed Comp.
 Dry Other (Core, Water Supply etc.)

If OWNED: old well info as follows:
Operator
Well Name
Comp. Date Old Total Depth

WELL HISTORY

Drilling Method:
 Mud Rotary Air Rotary Cable
02-24-88 03-02-88 03-02-88
Spud Date Date Reached TD Completion Date
2940
Total Depth PBD

Amount of Surface Pipe Set and Cemented at 276 feet
Multiple Stage Cementing Collar Used? Yes No
If yes, show depth set feet
If alternate 2 completion, cement circulated from feet depth to w/ SX cmt
Cement Company Name
Invoice #

API No. 15-131-20-138
County Nemaha
Approx. NW. NE. Sec. 10 Twp. 3S. Rge. 14 East West


4780 Ft North from Southeast Corner of Section
1950 Ft West from Southeast Corner of Section
(Note: Locate well in section plat below)

Lease Name Aberle "B" Well #. 1

Field Name Strahm South

Producing Formation Arbuckle

Elevation: Ground 1234 KB 1240

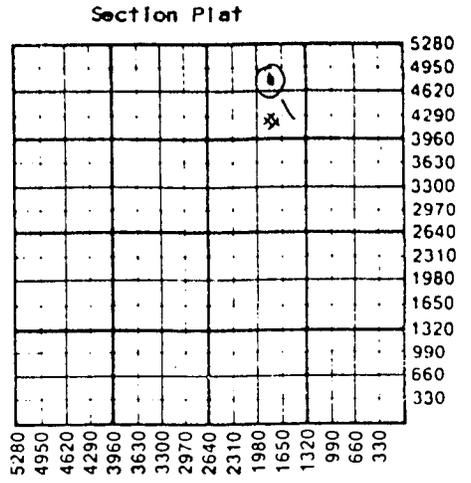

WATER SUPPLY INFORMATION

Disposition of Produced Water: Disposal
Docket # Repressuring

Questions on this portion of the ACO-1 call:
Water Resources Board (913) 296-3717
Source of Water:
Division of Water Resources Permit #
Groundwater Ft North from Southeast Corner (Well) Ft West from Southeast Corner of Sec Twp Rge East West
Surface Water Ft North from Southeast Corner (Stream, pond etc) Ft West from Southeast Corner Sec Twp Rge East West
Other (explain) (purchased from city, R.W.D. #)

INSTRUCTIONS: This form shall be completed in triplicate and filed with the Kansas Corporation Commission, 200 Colorado Derby Building, Wichita, Kansas 67202, within 120 days of the spud date of any well. Rule 82-3-130, 82-3-107 and 82-3-106 apply. Information on side two of this form will be held confidential for a period of 12 months if requested in writing and submitted with the form. See rule 82-3-107 for confidentiality in excess of 12 months. One copy of all wireline logs and drillers time log shall be attached with this form. Submit CP-4 form with all plugged wells. Submit CP-111 form with all temporarily abandoned wells.

RECEIVED
STATE CORPORATION COMMISSION
APR 4 1988