

Washington


Form 51-5M-2-29-34703

Map No. **KANSAS** Sec. 16 Twp. 3 R. 3E

Well No. 1- Penwell Farm

A. J. & Sonco Company

NORTH

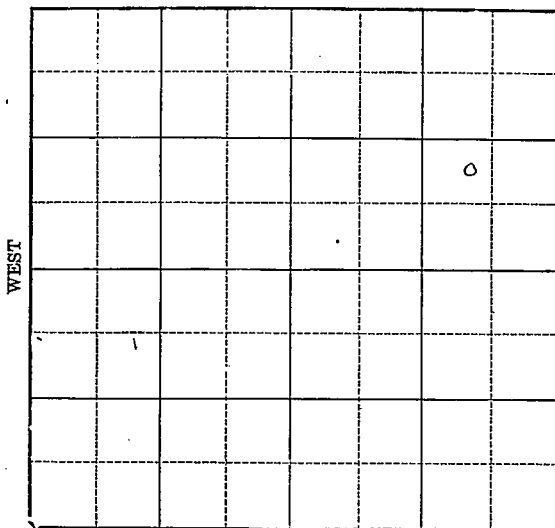

SOUTH

8

Location
Drilling Remarks

Rig Up
Drilling Remarks

RECORD

Cased _____ in. _____ ft.
Sand _____
Gas _____
Oil _____
Total Depth _____

PRODUCTION

1st 24 hrs. Nat. _____
1st 24 hrs. after shot _____
Gas _____ cu. ft. _____
Dry Hole _____
Abandoned _____

Map No. **KANSAS** Sec. 16 Twp. 3 R. 3E

Well No. 1- Penwell Farm

A. J. Sineox Company

NORTH

1800 Ft. from N. Line


_____ Ft. from S. Line

780 Ft. from E. Line

_____ Ft. from W. Line

1930

WEST

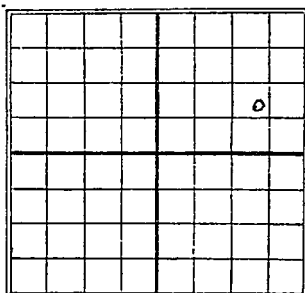

EAST

SOUTH

Date

REPORT

6/11	Drily
6/18	Drily 240'
6/25	—
7/2	Drily 600'
7/9	—
7/16	—
7/23	Drily 960'
	show gas. 754'
7/30	—
8/5	SD 960'
8/12	—
8/20	—
8/27	—
9/3	—
9/10	—
9/17	—
9/24	8"-1100'
	Drily 1365'
10/1	" " 1512'
10/8	—
10/15	UTR at 1600'
10/22	—

10/29- TD. 1600'
VIR 6"-1595'

11/5 —
11/12- Drly 1650'
11/19- 6"-1620

drly 1720'
11/26- S.D. 1720'

12/3	—	1931	—
12/10	—	6/10- S.D. 1750'	—
12/17	—	6/17	—
12/23	—	6/24	—
12/30	—	7/1	—
1931	—	7/8	—
1/7	—	7/15	—
1/14	—	7/22	—
1/21	—	7/29	—
1/28	—	8/5	—
2/4	—	8/12	—
2/11	—	8/19	—
2/18	—	8/26	—
2/25	—	9/2	—
3/3	—	9/9	—
3/11	—	9/16	—
3/18	—	9/23	—
3/25	—	9/30	—
4/1	—	10/7	—
4/8	—	10/14	—
4/15	—	10/21	—
4/22	—	10/27	—
4/29	—	11/4	—
5/6	—	11/10	—
5/13	—	11/18	—
5/20	—	11/24	—
5/27- S.D. 1750'	—	12/2	—
6/3	—	12/19	—






1800 Ft. from N. Line

Ft. from S. Line

780 Ft. from E. Line

Ft. from W. Line

1931

NORTH

WEST

EAST

SOUTH

Date _____

REPORT

12/16 S.D 1750'

12/22

12/30 —

1932

17/10	1
-------	---

1/10	
1/12	

113	
110	TH 1750

1119	LD 1/30
	Wrip & Abandon

Washington

Map No. **KANSAS** Sec. 16 Twp. 3 R. 3^EWell No. 1 Penwell
a. j. Sincox Company

Contractor

FIRST REPORTS

1800 Ft. from N. Line Ft. from S. Line780 Ft. from E. Line Ft. from W. Line

SECTION PLAT

			0

Location Rig up

Drilling and Remarks:

Spdy

RECORD

Cased in., ft.Sand Gas Oil Total Depth

PRODUCTION

1st 24 hrs. Nat. 1st 24 hrs. after shot Gas Cu. Ft.Dry Hole Abandoned Date
JUN 11 1930

CHAS. L. SHERWOOD

RECEIVED

no work

Returned	
Cards	
Tracing	
France Map	
Scarborough Map	
Moody Map	
Scarborough Flat Book	
Moody Flat Book	

18 Aug 1941

11

Washington
 Map No. KANSAS Sec. 16 Twp. 3 R. 3 ^E

Well No. 1 Penwell

A. J. Sinclair Company

Contractor

COMPLETED

SECTION PLAT

1800 Ft. from N. Line

_____ Ft. from S. Line

780 Ft. from E. Line

_____ Ft. from W. Line

ABANDONED

			0

Location _____

Rig up _____

Drilling and Remarks: _____

RECORD

Cased _____ in., _____ ft.

Sand _____

Gas _____

Oil _____

Total Depth 1750

PRODUCTION

1st 24 hrs. Nat. _____

1st 24 hrs. after shot _____

Gas _____ Cu. Ft.

Dry Hole ☒

Abandoned ☒

Date

JAN 20 1932

192 CHAS. L. SHERWOOD
 Scout

no wall
no small map

Returned	<i>JB</i>
Cards	
Tracing	<i>MUS.</i>
France Map	<i>MUS.</i>
Scarborough Map	<i>X</i>
Moody Map	
Scarborough Flat Book	
Moody Flat Book	