

15117000190000


FORM 51 25M 8-50 WESTERN

Marshall **KANSAS**

Section 22 Township 3 Range 7E

Well No. #1 Randel

Company Falcon-Seaboard

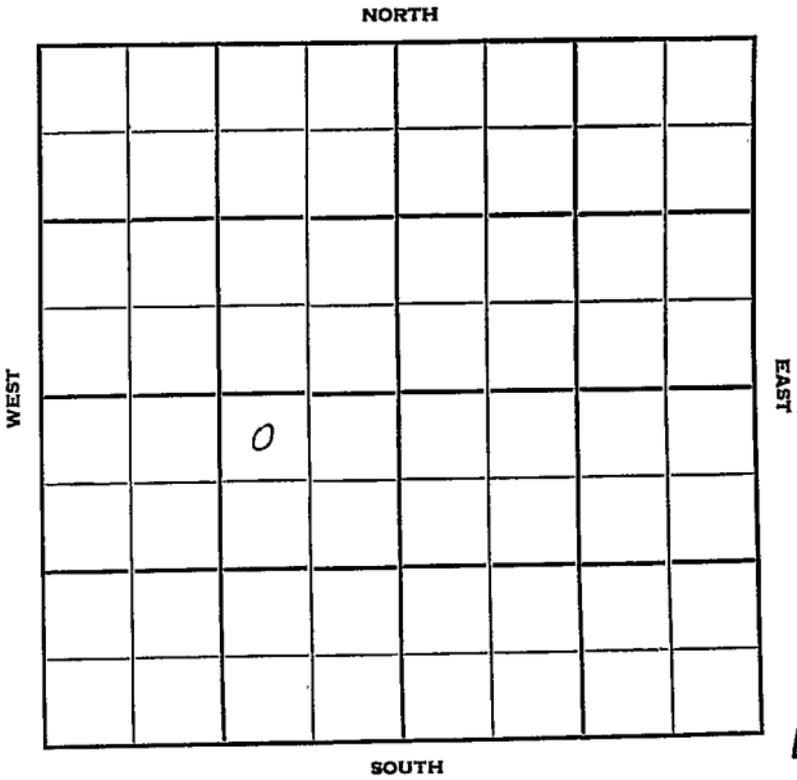

Sec. 22 Twp. 3 R. 7 E ✓

Well No. # 1 Randel Farm

Falcon-Seaboard Company

Uhl - Contr. Contractor

Wildcat


330 Ft. from N. Line

\_\_\_\_\_ Ft. from S. Line

990 Ft. from E. Line

\_\_\_\_\_ Ft. from W. Line

NW NE SW

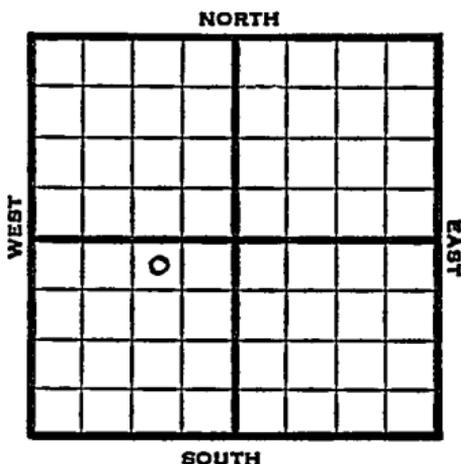

1951 Elev. 1302' REPORT

4/11 Spud 4-9-51  
Drlg.

4/25 Spud 4-9-51  
D & A TD 2322'  
8" @ 105 Lans. 1150' Marmaton 1385'  
Cong. 1490, Hunton 1516', Maq. 1830  
Viola 1872' Decora 2075' Simp 2200  
Gr. wash 2255' Granite 2295'  
TD 2322' D & A

**ABANDONED**

Lzn + 159	$\begin{array}{r} 1309 \\ 1150 \\ \hline - 159 \end{array}$	$\begin{array}{r} 1395 \\ 1309 \\ \hline - 76 \end{array}$
Bkc - 76		
M - 181		
L-M 340	$\begin{array}{r} 1490 \\ 1309 \\ \hline 181 \end{array}$	$\begin{array}{r} 1490 \\ 1150 \\ \hline 340 \end{array}$
Bkc - M 105		$\begin{array}{r} 181 \\ 76 \\ \hline 105 \end{array}$



County **Marshall** State **Kansas**

Sec. **22** (Blk. Twp.) **3** (Sur. Rge.) **7E** Map No.

Operator **Falcon - Seaboard**

Well No. **1** Farm **Randel**

Elev. **1** Location **NW NE SW**

FIRST REPORT									

**330** Ft. From **N** Line **SW**

**990** Ft. From **E** Line Quarter

1st. Report **APR 11 1951**

Completion

Remarks

**Uh1 - Contr.**

Spudding Date **4-9-51**

Drlg. Data **Wildcat**

**drlg.**