

15131000090000

KANSAS

FORM 51 25M 3-49 PETROL

Nemaha

Section 26 Township 3 Range 13E

Well No. #1 J. E. Smart

Company Davon Oil

NORTH

0							

WEST

EAST

SOUTH

4

Sec. 26 Twp. 3 R. 13E

Well No. #1 J. E. Smart Farm

Davon Oil Company

Davon Oil Contractor

Wildcat


330' Ft. from N. Line

_____ Ft. from S. Line

_____ Ft. from E. Line

330' Ft. from W. Line

NW NW NW
Carter Farmout

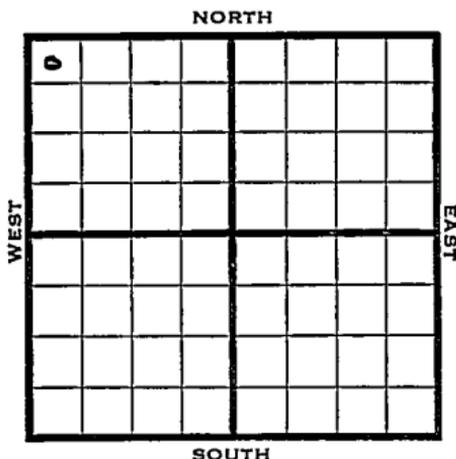

1950

REPORT

2/15

Location

3/1

10-3/4" @ 247'

Howard 350'

Topeka 393

KC 750'

Viola 1850'

No shows

D&A

TD 1930'

ABANDONED

Map No. _____ Sec. 26 Twp. 3 R. 13EWell No. 1 J. E. Swart_____
Davon Oil _____ Company_____
Davon Oil _____ Contractor

NW NW NW

SECTION PLAT

330 Ft. from N. Line_____
Ft. from S. Line_____
Ft. from E. Line330 Ft. from W. Line

Nemaha County

Carter farmout

Location _____

Rig up _____

Drilling and Remarks:

RECORD

Cased _____ in., _____ ft.

Sand _____

Gas _____

Oil _____

Total Depth _____

PRODUCTION

1st 24 hrs. Nat. _____

1st 24 hrs. after shot _____

Gas _____ Cu. Ft.

Dry Hole _____

Abandoned _____

Date

FEB 15 1950 19J. E. TYRA Scout

Map No. _____ Sec. 26 Twp. 3 R. 13EWell No. 1 J. E. Swart

Day on Oil _____

Company _____

Contractor _____

NW NW NW

E1. 1284
SECTION PLAT330 Ft. from N. Line

_____ Ft. from S. Line

_____ Ft. from E. Line

330 Ft. from W. Line

0			
ABANDONED			

Nemaha County

Location _____

Rig up _____

Drilling and Remarks:

10 3/4" @ 247Harwood 350Joseph 393K.C. 750Viola 1850No Shaws

RECORD

Cased _____ in., _____ ft.

Sand _____

Gas _____

Oil _____

Total Depth 1930

PRODUCTION

1st 24 hrs. Nat. _____

1st 24 hrs. after shot _____

Gas _____ Cu. Ft.

Dry Hole _____

Abandoned _____

Date

DFA.

MAR 1 1950

19

J. E. TYRA

Scout