


Washington 15201000070000
Form 51-5M-4-27-27428
Map No. ANSAS Sec. 3 Twp. 3 ^S R. 4E
Well No. 1 - Stonn Farm
Elder & Ward Company

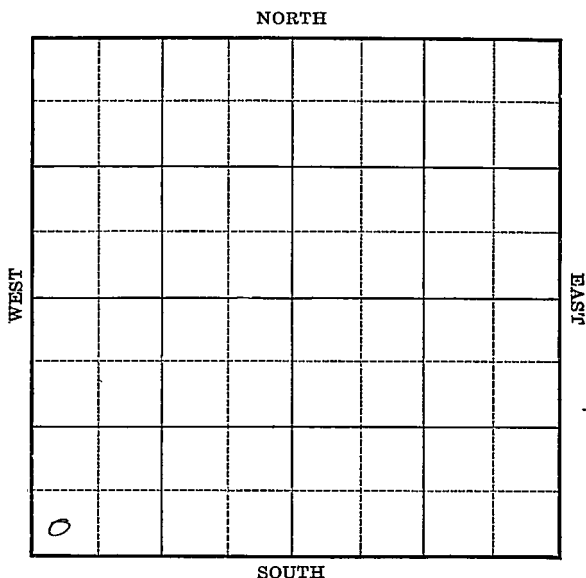

Location _____

Drilling Remarks _____

Rig Up _____

Drilling Remarks _____

RECORD

Cased _____ in. _____ ft.

Sand _____

Gas _____

Oil _____

Total Depth _____

PRODUCTION

1st 24 hrs. Nat. _____

1st 24 hrs. after shot _____

Gas _____ cu. ft.

Dry Hole _____

Abandoned _____

KANSAS

Map No. Sec. Twp. R.

Well No. Farm


..... Company

..... Ft. from N. Line

..... Ft. from S. Line

..... Ft. from E. Line

..... Ft. from W. Line

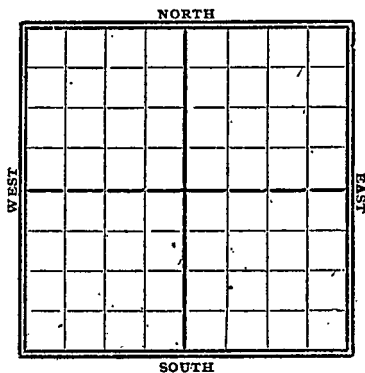

Date	REPORT
	Gypsy Records
1921 7/21	Abd. T.D. 3400

MAP No. _____ SEC. 3 TWP. 35 R. 4E

WELL No. 1 Stann

Elder + Hard COMPANY

no well map CONTRACTOR

SECTION PLAT

0			

_____ FT. FROM N. LINE

_____ FT. FROM S. LINE

_____ FT. FROM E. LINE

_____ FT. FROM W. LINE

LOCATION _____

RIG UP _____

DRILLING AND REMARKS:

3070 to 3040
had minnow
show of oil

RECORD

CASED _____ IN. _____ FT.

SAND _____

GAS _____

OIL _____

TOTAL DEPTH 3110'

PRODUCTION

1ST 24 HRS. NAT. _____

1ST 24 HRS. AFTER SHOT _____

GAS ✓ CU. FT.

DRY HOLE _____

ABANDONED ✓

DATE

7/21 1921

SCOUT

Washington

tracing
 P No. KANSAS SEC. 3 TWP. 35 R. ✓ E

ELL No. 1Elder & Ward

COMPANY

CONTRACTOR

SECTION PLAT

0			

Ft. FROM N. LINE

Ft. FROM S. LINE

Ft. FROM E. LINE

Ft. FROM W. LINE

RECORD

CASED _____ IN. _____ FT.

SAND _____

GAS _____

OIL _____

TOTAL DEPTH 2400

PRODUCTION

1ST 24 HRS. NAT. _____

1ST 24 HRS. AFTER SHOT _____

GAS _____ CU. FT.

DRY HOLE ✓ABANDONED ✓

LOCATION _____

RIG UP _____

DRILLING AND REMARKS:

well
 no info

DATE

7/21

1921

SCOUT