

15131000200000


FORM 51 25M 8-50 WESTERN

Nemaha **KANSAS**

Section 3 Township 3 Range 14E

Well No. #1 Aberle

Company E. J. Ryan et al

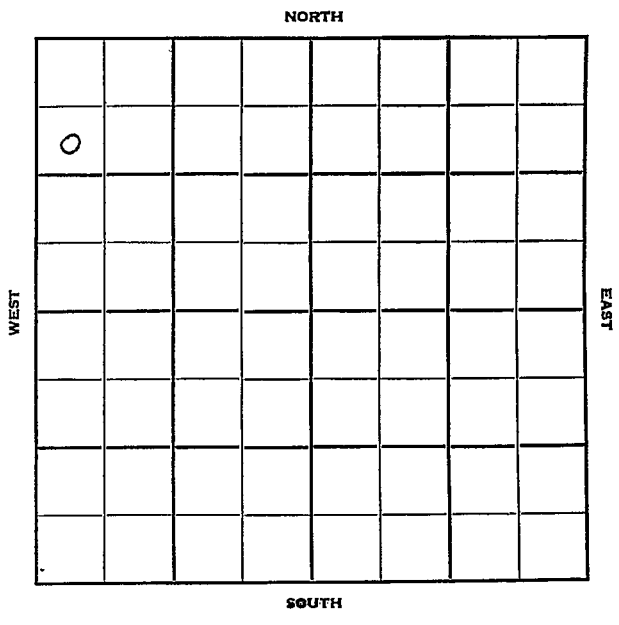

4

Sec. 3 Twp. 3 R. 14E ✓

Well No. #1 Aberle Farm

E.J. Ryan et al Company

Transit Drlg. -Contr. Contractor

Wildcat


990' Ft. from N. Line

_____ Ft. from S. Line

_____ Ft. from E. Line

330' Ft. from W. Line

SW NW NW

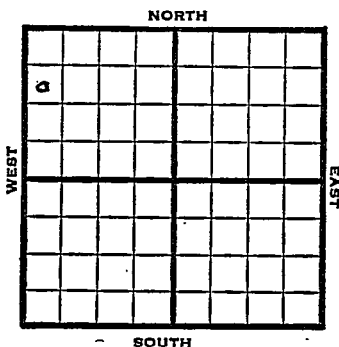

1951 Elev. 1280' REPORT

1/24 Spud 1-20-51
8" @ 198'
Drlg. 1168'

2/7 Spud 1-20-51
D&A TD 3798
8" @ 198' Miss 2574'
B. Miss 2759' Hunton 3014
Maq. 3644' Viola 3699'
TD 3798' D&A

ABANDONED

County Nemaha State Kansas

Sec. 3 (Blk. 3 (Sur. 14E Map No. 14E)
 (Twp.) (Rge.)

Operator E. J. Ryan et al.

Well No. 1 Farm Aberle

Elev. _____ Location SW NW NW

0					

990 Ft. From N Line NW

330 Ft. From W Line Quarter

Ist. Report. JAN 24 1951

Completion _____

Remarks _____

Transit Drlg. + Contr.

Spudding Date 1-20-51

Drlg. Data Wildcat

8" @ 198 drlg. 1168

J. E. TYRA

County Nemaha State Kansas

Sec. 3 (Blk. 3) (Sur. 14E) (Twp.) 3 (Rge.) 14E Map No.

Operator E. J. Ryan etal.

Well No. 1 Farm Aberle

Elev. 1280 Location SW NW NW

0					

990 Ft. From N Line NW

330 Ft. From W Line Quarter

1st. Report

Completion FEB 7 1951

Remarks Wildcat

Transit Drlg. - Contr.

Spudding Date 1-20-51

Drlg. Data D & A TD 3798

8" @ 198 Miss. 2574 B. Miss. 2759

Hunton 3014 Maq. 3644 Viola 3699

TD 3798 D & A

J. E. TYRA