

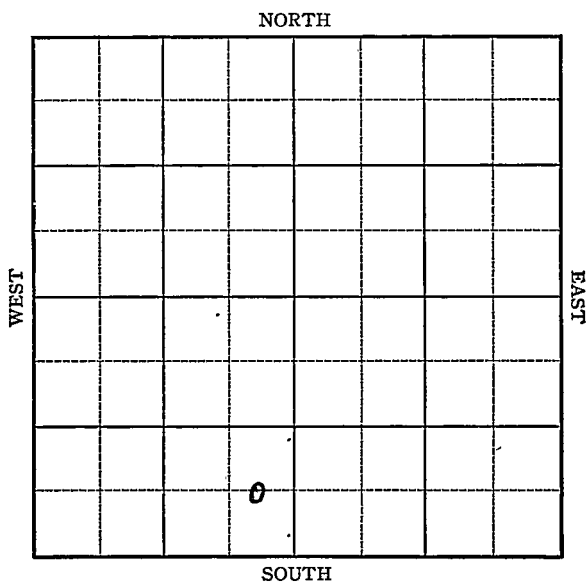
KANSAS

15043000030000

1

FORM 51 5M 4-41 PETROL

Doniphan

Section 31 Township 3 Range 20EWell No. 1 Ross ~~and~~ ElliottCompany Jock Garden et al

14

Sec. 31 Twp. 3 R. 20-E

Well No. #1 Ross ~~HA~~ Elliott Farm

Jock Garden et al _____ Company

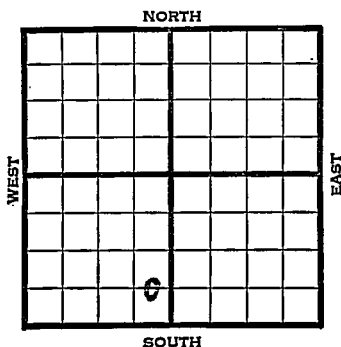
(Wild cat)

Ft. from N. Line

660 Ft. from S. Line

330 Ft. from E. Line

Ft. from W. Line

[illegible]

Map No. 11M Sec. 31 Twp. 3 R. 20EWell No. 1 Ross ElliottJock Garden etal

Company

ABANDONED

Contractor

SECTION PLAT

C E L S E S W

 Ft. from N. Line660 Ft. from S. Line330 Ft. from E. Line Ft. from W. Line

WILDCAT

Location Rig up

Drilling and Remarks:

Cert. 2898
Nochope

RECORD

Cased in., ft.Sand Gas Oil Total Depth 2950

PRODUCTION

1st 24 hrs. Nat. 1st 24 hrs. after shot Gas Cu. Ft.Dry Hole Abandoned

Date

JUL 1 1941

19

S. J. LEWIS Scout

Map No. NM Sec. 31 Twp. 3 R. 20EWell No. 1 Ross ElliottJock Garden etal CompanyCORRECTION Contractor

C E L S E S W

 Ft. from N. Line660 Ft. from S. Line330 Ft. from E. Line Ft. from W. Line**SECTION PLAT**

WILDCAT

Location Rig up Drilling and Remarks: Reported as

#1 Ross "A"

RECORDCased in., ft.Sand Gas Oil Total Depth **PRODUCTION**1st 24 hrs.-Nat. 1st 24 hrs. after shot Gas Cu. Ft.Dry Hole Abandoned

Date

JUN 11 1941 19 S. J. LEWIS Scout

Map No. NM Sec. 31 Twp. 3 R. 20EWell No. 1 Ross "A"Jock Garden etal

Company

Contractor

FIRST REPORT

C E L S E S W

_____ Ft. from N. Line

660 Ft. from S. Line330 Ft. from E. Line

_____ Ft. from W. Line

SECTION PLAT

WILDCAT

Location _____

Rig up _____

Drilling and Remarks:

Rotary

RECORD

Cased _____ in., _____ ft.

Sand _____

Gas _____

Oil _____

Total Depth _____

PRODUCTION

1st 24 hrs. Nat. _____

1st 24 hrs. after shot _____

Gas _____ Cu. Ft.

Dry Hole _____

Abandoned _____

Date

JUN 4 1941S. J. LEWIS Scout