15117000280000

FORM 51 10M 7-48 PETROL

KANSAS Marshall

Section 34 Township 3 Range 7E

Well No. 1 Romback

Company Aladdin & Thrifty

Wildcat

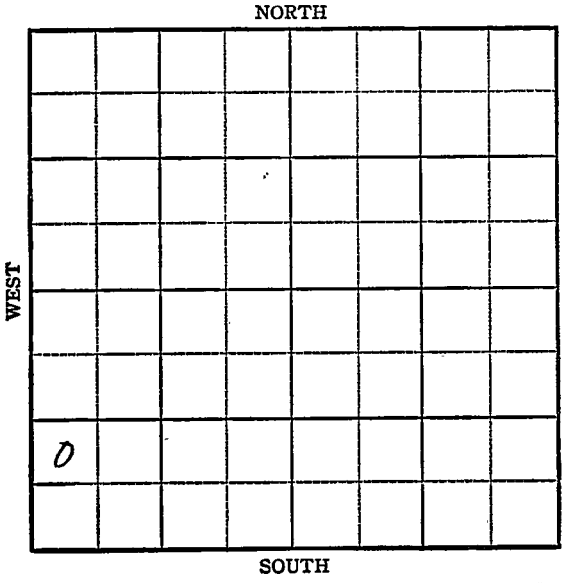

13

FORM 252-A
5M 10-48 PETROL

KANSAS Marshall

Sec. 34 Twp. 3 R. 7E ✓

Well No. #1 Romback Farm

Aladdin & Thrifty Company

Wildcat

_____ Ft. from N. Line

990' Ft. from S. Line

_____ Ft. from E. Line

330' Ft. from W. Line

NW SW SW

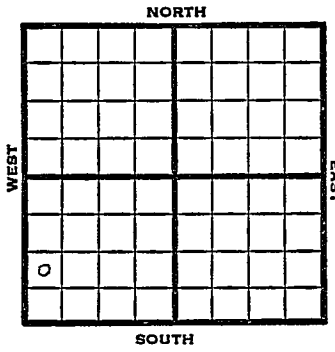

1948	Elev. 1372' REPORT
11/10	RUR
11/16	"
11/23	Topka 960' KC 1170 Hunton 1632 TD 1815'
12/30	"
12/8	"
12/15	"
12/22	Hunton 1632' TD 1915' ABANDONED

1632
1372
-260

1372
960
412

1632
960
672

Form 26 200 Bks. 9-48 Petrol

Kansas

Wildcat

Map No. _____ Sec. 34 Twp. 3 R. 7E

Well No. 1 Rombeck

Aladdin & Thrifty Company

FIRST REPORT Contractor

NW SW SW

SECTION PLAT

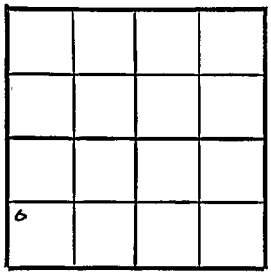

_____ Ft. from N. Line

990 Ft. from S. Line

_____ Ft. from E. Line

330 Ft. from W. Line

Marshall County

Location _____

Rig up _____

Drilling and Remarks:

R U R

RECORD

Cased _____ in., _____ ft.

Sand _____

Gas _____

Oil _____

Total Depth _____

PRODUCTION

1st 24 hrs. Nat. _____

1st 24 hrs. after shot _____

Gas _____ Cu. Ft.

Dry Hole _____

Abandoned _____

Date

NOV 10 1948 19

S. J. LEWIS Scout

Form 26 200 Bks. 9-48 Petrol

Kansas

Wildcat

Map No. 124 Sec. 34 Twp. 3 R. 7E

Well No. 1 Rombeck

Aladdin & Thrifty Company

ABANDONED Contractor

NW SW SW

E. 1,372

SECTION PLAT

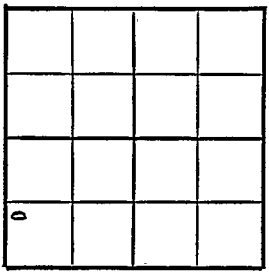

____ Ft. from N. Line

990 Ft. from S. Line

____ Ft. from E. Line

330 Ft. from W. Line

Marshall County

Location

Rig up

Drilling and Remarks:

Hanton 1632

RECORD

Cased ____ in., ____ ft.

Sand

Gas

Oil

Total Depth 1915

PRODUCTION

1st 24 hrs. Nat.

1st 24 hrs. after shot

Gas ____ Cu. Ft.

Dry Hole

Abandoned

Date

DEC 22 1948 19

S. J. LEWIS Scout