

KANSAS 15013000090000

Brown

Section 4 Township 3 Range 15-E

Well No. #1 Tyler

Company McAlpine et al

NORTH Wildcat

[illegible]

SOUTH


13

Sec. 4 Twp. 3 R. 15-EWell No. #1 Tyler FarmMcAlpine et al Company

(Wildcat)

 Ft. from N. Line990 Ft. from S. Line Ft. from E. Line990 Ft. from W. Line

Elev. 1121

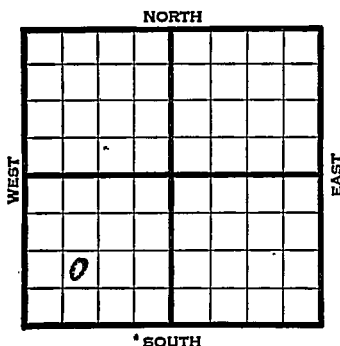

1940	REPORT
12/11	Machine 40'
	Run 15".
12/19	Shut down.
12/26	15" - 37'
	TD 50' SD.
1941	
1/2	Drlg. 210'
1941	
1/9	Drlg. 260'
1/16	15" - 88' 10" - 225'
	Drlg. 260'
1/23	H.F.W. 810-60' Drlg. 975'
1/30	1000' SD for 8".
2/6	" " "
2/13	" " "
2/20	" " "
2/27	" " "
3/6	SD 1045'
3/13	"
3/20	"
3/27	"
	OVER

1941	
4/3	SD 1045'
4/10	"
4/18	"
4/24	"
5/1	"
5/8	"
5/15	"
5/22	8" - 1045'
	Drlg. 1150'
5/28	Drlg. 1850'
6/5	SD 1850'
6/12	"
6/19	"
6/26	"
7/3	"
7/10	"
7/17	"
7/24	"
7/31	"
8/7	"
8/15	"
8/21	"
8/27	T.D. 1550'

ABANDONED

Map No. 122 Sec. 4 Twp. 3 R. 15EWell No. 1 TylerMcAlpine etal CompanyABANDONED Contractor

SECTION PLAT

NE SW SW

 Ft. from N. Line990 Ft. from S. Line Ft. from E. Line990 Ft. from W. Line

o			

WILDCAT

Location Rig up

Drilling and Remarks:

RECORD

Cased in., ft.Sand Gas Oil Total Depth 1550

PRODUCTION

1st 24 hrs. Nat. 1st 24 hrs. after shot Gas Cu. Ft.Dry Hole Abandoned

Date

AUG 27 1941 19S. J. LEWIS Scout

Misc. Small Maps	
Cards	
Tracing	
France Map	
Scarborough Map	
Woody Map	
Geological Dept.	
Index Map Book	

Map No. 122 Sec. 4 Twp. 3 R. 15EWell No. 1 TylerMcAlpine etal Company

Contractor

FIRST REPORT

NE SW SW

 Ft. from N. Line990 Ft. from S. Line Ft. from E. Line990 Ft. from W. Line

WILDCAT

SECTION PLAT

•			

Location Rig up

Drilling and Remarks:

Machine 40'

Run 15"

RECORD

Cased in., ft.Sand Gas Oil Total Depth

PRODUCTION

1st 24 hrs. Nat. 1st 24 hrs. after shot Gas Cu. Ft.Dry Hole Abandoned

Date

DEC 11 1940 19 S. J. LEWIS Scout

Misc. Small Maps

Cards

Tracing

France Map

Scarborough Map

Moody Map

Geological Dept.

Moody Flat Book