

KANSAS


FORM 51 5M PETROL

Marshall

Section 10 Township 4 Range 7-E

Well No. #1 Cox

Company B. B. Blair

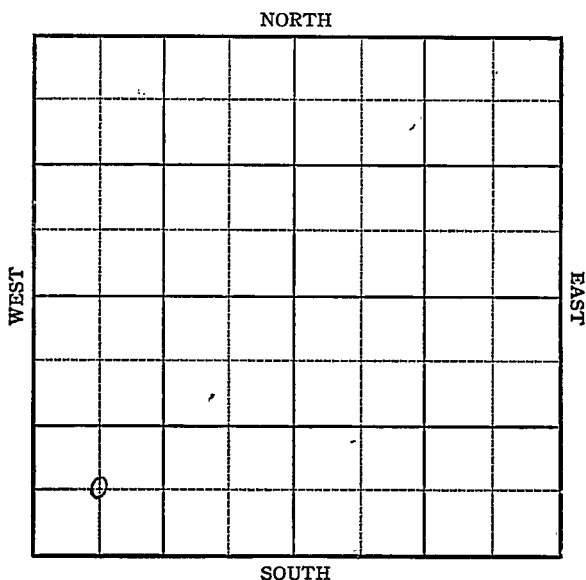


13

KANSAS

Marshall

Sec. 10 Twp. 4 R. 7-EWell No. #1 Cox FarmB. B. Blair Company

NORTH

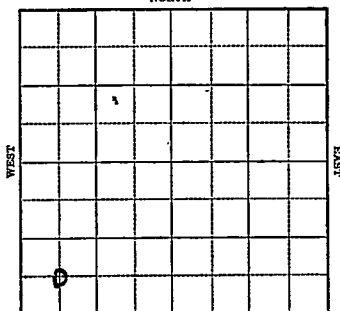

SOUTH

 Ft. from N. Line660 Ft. from S. Line Ft. from E. Line660 Ft. from W. Line

R E P O R T

1943

10/27 Drlg. 1276' Tight hole.

11/3 8" @ 1282
Drlg. 1331'

11/10 1400 UR 8"

11/17 12" @ 39'; 10" @ 866'; 8" @ 1454
Lime 1445
Drlg. 1500'11-24 8" @ 1485
Drlg. 1650'

12/1 Drlg. 1880

12/8 Drlg. 2037

12-15 S.D. for csg.

12/22 " " "

12/29 " "

1944

1-5 " "

1-12 " "

1993
1418
575

OVER

1948
1/19

Lans 1082
BKC 1331
Hunton 1418 ?
Viola 1804
Simp 1993
Reagan 2117
TD 2175

1418
1331
87

1331

ABANDONED

1418

1418
1082
336 ✓

1418
1331
87

KANSAS

Map No. 2 Sec. 10 Twp. 4 R. 7EWell No. 1 CoxB. B. Blair

Company

ABANDONED

Contractor

C SW SW

SECTION PLAT

		o	

 Ft. from N. Line660 Ft. from S. Line Ft. from E. Line660 Ft. from W. Line

Wildcat

Location Rig up

Drilling and Remarks:

*Loss 1082**BHC 1331**Hunter 1418?**Vota 1804**Sm 1998**Reagan 2117*

RECORD

Cased in., ft.Sand Gas Oil Total Depth 2125

PRODUCTION

1st 24 hrs. Nat. 1st 24 hrs. after shot Gas Cu. Ft.Dry Hole Abandoned

Date

JAN 19 1944

19

S. J. LEWIS Scout

no more

Misc. Small Maps *No Small Map - Orma*
Cards *Bridge*
Tracing *MBL*
France Map ☒
Scarborough Map ☒
Moody Map ☒
Geological Dept.
Moody Plat Book

KANSAS
 Map No. 124 Sec. 10 Twp. 4 R. 7E

Well No. 1 COX

B. B. Blair


Company

FIRST REPORT

Contractor

C SW SW

SECTION PLAT

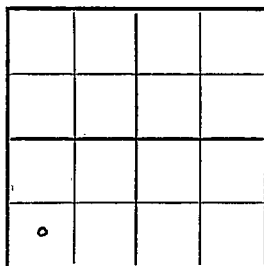

 Ft. from N. Line

660 Ft. from S. Line

 Ft. from E. Line

660 Ft. from W. Line

Wildcat

Location

Rig up

Drilling and Remarks:

1276

Tight hole

RECORD

Cased in., ft.

Sand

Gas

Oil

Total Depth

PRODUCTION

1st 24 hrs. Nat.

1st 24 hrs. after shot

Gas Cu. Ft.

Dry Hole

Abandoned

Date

OCT 27 1943

19

S. J. LEWIS

Scout

no well

[Signature]

Misc. Small Maps	<i>Yes</i>
Cards	<i>Book</i>
Tracing	<i>Yes</i>
France Map	<i>X</i>
Scarborough Map	<i>X</i>
Pierce Map	<i>X</i>
Geological D. & T.	
Pierce Plat Book	

Yes small map One