

KANSAS

Nemaha

Form 51-5M-7-39-Palace


15131300430000

Section 12 Township 4 Range 14-E

Well No. #1 Achten

Company Bumbus et al

NORTH Wildcat

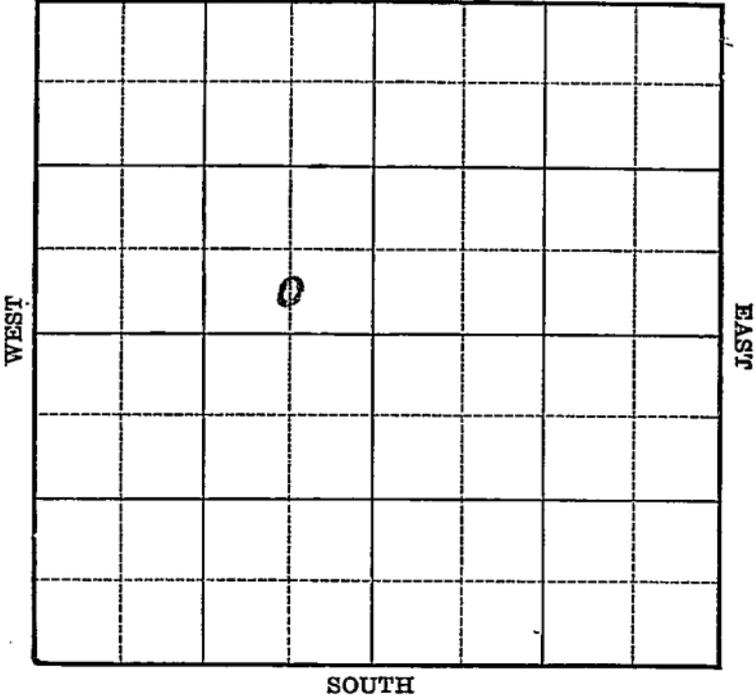

6

1940
 12/5 SD 1890'
 12/12 "
 12/19 "
 12/26 "
 1941
 1/2 "
 1/9 6" - 1908'
 Drlg. 1920'
 1/16 6" - 1945' T.D. 1960'
 U.R. 6".
 1/23 6" - 1990'
 TD 1992' SD.
 1/30 6" - 1995'
 TD 2007' SD.
 2/6 " "
 2/13 " "
 2/20 " "
 2/27 " "
 3/6 Topeka 690' Douglas 1060'
 K.C. 1210' Marmaton 1550'
 6" - 2015' Drlg. 2025'
 3/13 Should be 6" at 2015'
 U.R. to 2098'
 Drlg. 2142'
 3/20 6" - 2183'
 Drlg. 2187'
 3/27 6" - 2205'
 Drlg. 2245'
 4/3 2245' fsg.
 4/10 " "
 4/18 " "
 4/24 Fsg. tools 2270'
 5/1 " " "
 5/8 " " "
 5/15 " " "
 5/22 6" - 2300'
 Drlg. 2350'

OVER

1941		
5/28	SD 2350'	
6/5	"	
6/12	Miss. 2512'	
	Drlg. 2517'	
6/19	Miss. 2553' (Corrected)	
	TD 2560' SD.	
6/26	"	"
7/3	"	"
7/10	"	"
7/17	"	"
7/24	"	"
7/31	"	"
8/7	"	"
8/15	"	"
8/21	"	"
8/28	TD 2563' SD.	
9/4	"	"
9/11	"	"
9/18	TD 2580' SD.	
9/25	"	"
10/2	"	"
10/9	"	"
10/16	SD 2870'	
10/23	"	
10/30	"	
11/6	"	
11/13	Hunton 2975'	
	TD 2976' SD.	
11/20	Drlg. 3100'	
11/25	Hunton 2958'	
	T.D. 3130'	
	No shows.	

~~2975~~
~~2553~~

422

ABANDONED

Map No. 122 Sec. 12 Twp. 4 R. 14E

Well No. 1 Achten

Bumbus etal Company

CORRECTION Contractor

C S L SE NW

 Ft. from N. Line

330 Ft. from S. Line

660 Ft. from E. Line

 Ft. from W. Line

SECTION PLAT

WILDGAT

Location

Rig up

Drilling and Remarks:

Reported

12-12-14E

RECORD

Cased in., ft.

Sand

Gas

Oil

Total Depth

PRODUCTION

1st 24 hrs. Nat.

1st 24 hrs. after shot

Gas Cu. Ft.

Dry Hole

Abandoned

Date

JUN 26 1949

S. J. LEWIS Scout

Map No. _____ Sec. 12 Twp. 12 R. 14EWell No. 1 AchtenBumbus etal

Company _____

Contractor _____

FIRST REPORT

C S L SE NW

_____ Ft. from N. Line

330 Ft. from S. Line660 Ft. from E. Line

_____ Ft. from W. Line

WILDCAT

SECTION PLAT

Location _____

Rig up _____

Drilling and Remarks:

Machine

RECORD

Cased _____ in., _____ ft.

Sand _____

Gas _____

Oil _____

Total Depth _____

PRODUCTION

1st 24 hrs. Nat. _____

1st 24 hrs. after shot _____

Gas _____ Cu. Ft.

Dry Hole _____

Abandoned _____

Date

JUN 26 1940 19S. J. LEWIS Scout