

Brown

KANSAS

KANSAS

Brown

Map No. MM Sec. 24 Twp. 4 R. 16E

Sec. 24 Twp. 4 R. 16-E

Well No. 4 Stratigraph

Well No. #4 Stratigraph Farm

Carter Oil Company


Carter Oil Company

FIRST REPORT

COMPLETED

SW/C

SECTION PLAT

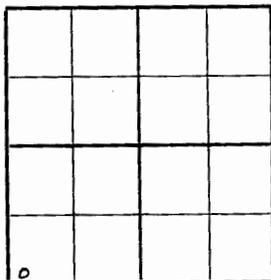

Ft. from N. Line

330 Ft. from S. Line

330 Ft. from E. Line


Ft. from W. Line

Ft. from N. Line

330 Ft. from S. Line

330 Ft. from E. Line

Ft. from W. Line

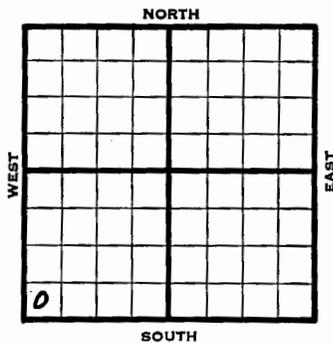

Location

Rig up

Drilling and Remarks:

No shows

RECORD

Cased in. ft.

Sand

Gas

Oil

Total Depth 3500

PRODUCTION

1st 24 hrs. Nat.

1st 24 hrs. after shot

Gas Cu. Ft.

Dry Hole

Abandoned

1941 Elev. 1112' REPORT

12/3 Miss. 2163'

Kinderhook Shale 2445'

Hunton 2676'

Viola 3196'

Simpson 3360'

Arb. 3444'

T.D. 3500' No shows.

FIRST REPORT

*and*

ABANDONED

Date

DEC 3 1941 19 S. J. LEWIS Scout

*2163'*

*3360'*  
*2676'*  
*3196'*

*3444'*  
*3500'*  
*12/3*