

1513100021000

Nemaha

KANSAS

FORM 51 25M 3-49 PETROL

Section 16 Township 4 Range 12E

Well No. # 1 Knightengale

Company M.C. Calhoun

NORTH

WEST

EAST

SOUTH

Nemaha

KANSAS
12 E ✓

Sec. 16 Twp. 4 R. 12 E

Well No. # 1 Knightengale Farm

M. C. Calhoun Company

Contractor


_____ Ft. from N. Line

990 Ft. from S. Line

330 Ft. from E. Line

_____ Ft. from W. Line

NE SE SW

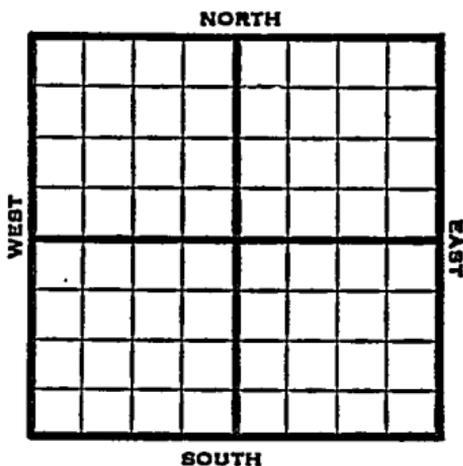

1951

Elev. ?

REPORT

5/23

D & A TD 808'
10" @ 186 8" @ 250 6" @ 668'
TD 808' D & A

FIRST REPORT

✓
ABANDONED