

County: Brown Fr _____ Sec. 23 T 4 S R18 E/W

CORRECTION(S) TO _____ COMPLETION RECORD (WWC-5)

(To rectify lacking or incorrect information)

Owner: KDOT

Location was listed as:

~~Section-Township-Range: _____~~

Changed to:

~~Fraction (1/4 1/4 1/4): _____~~

Other changes: Initial statements: _____

Station # 181+90, 50' RT & K-20


Changed to: _____

Comments: KDOT core available for CD1 also

(no paperwork available as of 12/10/2015)

Verification method: _____

Submitted by: Kansas Geological Survey, Data Resources Library, 1930 Constant Ave., Lawrence KS 66047-3726
to: Kansas Dept of Health & Environment, Bureau of Water, 1000 SW Jackson, Suite 420, Topeka, KS 66612-1367.
initials: CN date: 12/10/2015

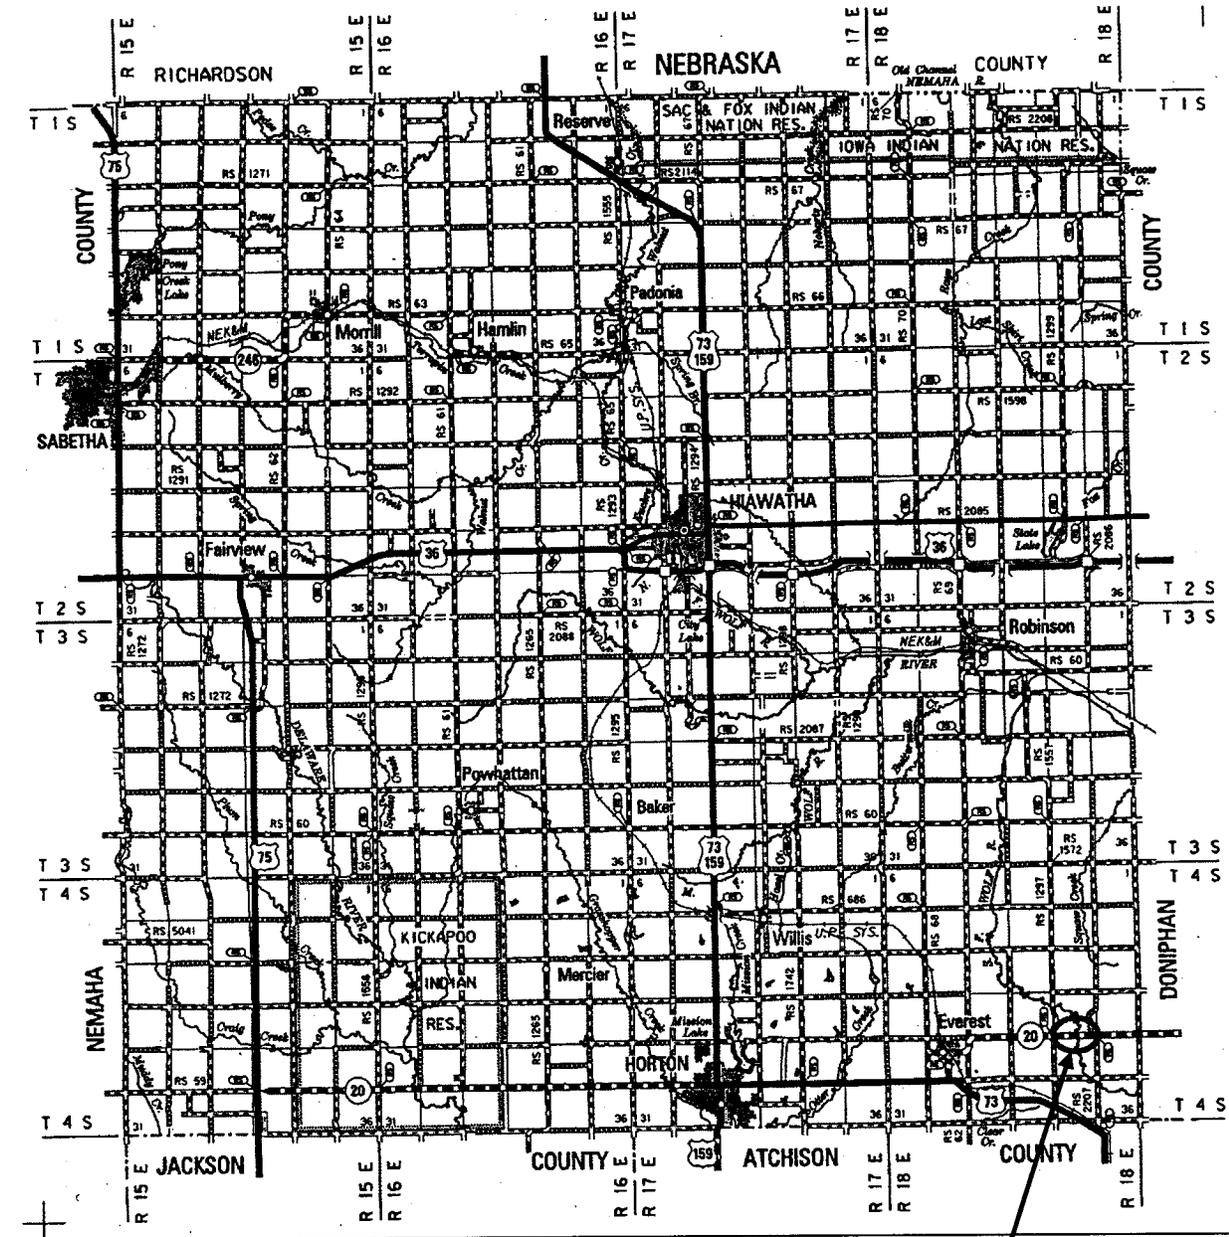

20-7 KA-2054-01 K-20 over South of Fork Wolf Creek

Bridge No. 20-7-20.28(063)

Brown County

CD 02

N: 39.681951 E: -95.368969(Approx.)

SW ¼, SW ¼, SE ¼, Section 23, T04S, R18E