

15643000000000
DX 78-1


Doniphan

KANSAS

Section 19 Township 4 Range 21 E

Well No. #1 Geo. Reder

Company Gordon Curtis

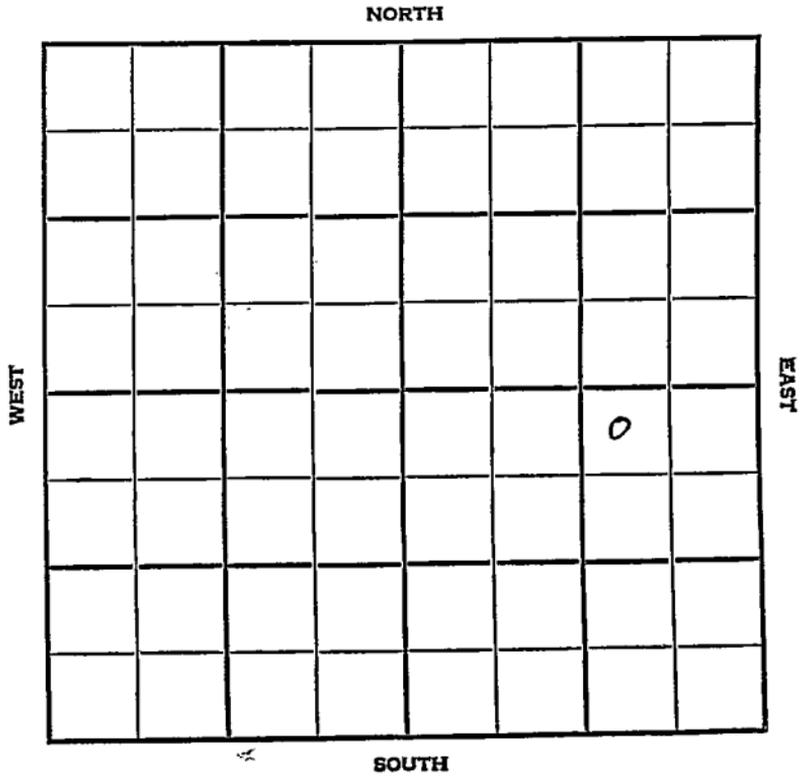

9

use 45-16^E
Strip Log.

Doniphan

KANSAS

SEC. 19	TWP. 4	R. 21E
------------	-----------	-----------


WELL NO. #1 Geo Reder FARM

COMPANY Gordon Curtis

CONTRACTOR Nemaha

Wildcat

_____ Ft. from N. Line
 _____ Ft. from S. Line
 _____ Ft. from E. Line
 _____ Ft. from W. Line

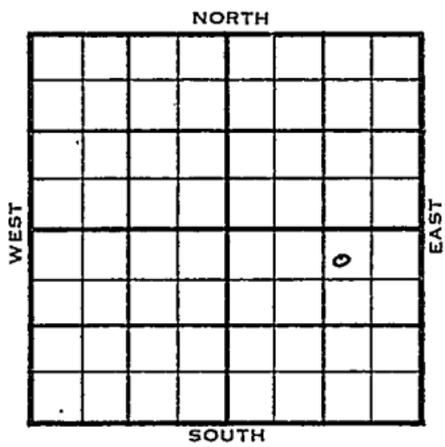

NW NE SE

1955	ELEVATION	REPORT
------	-----------	--------

1000'

10/5	RUR	
10/19	Comm 10-6-55	
	8 5/8" @ 90	
	L	545
	BKC	710
	Ce	890
	M	1560
	K	1930
	Mz	2034
	Hunton	2046
	TD	2077
	D & A	

*2046
 1560

 486*


ABANDONED

Na County

County Doniphan Elev. 1000
 Sec. 19 Twp. 4 Rge. 21E
 Company Gordon Curtis
 Farm Name Geo. Reder No. 1

TOPS	DEPTH	LOG	DATUM
Anh.			
Tr.			
H.			
Tr.			
Dg.			
Bl.			
L.	<u>545</u>		
K.C.			
B.K.C.	<u>710</u>		
Ce.	<u>890</u>		
C.			
M.	<u>1560</u>		<u>560</u>
M.			
K.	<u>1930</u>		<u>930</u>
Mz.	<u>2034</u>		<u>1034</u>
Mo. <u>Huntow</u>	<u>2046</u>		<u>1046</u>
V.			
S.			
S.			
A			
R.			
PE.			
G.			
TD.	<u>2077</u>		

Loc. in Sec. NW NE SE
 Geol. _____
 Contr. _____
Nemaha
 Pool _____
Wildcat

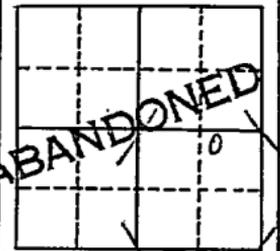

Date Comm. 10-6-55 OCT 19 1955
8 5/8" @ 80

D & A

Co.
Lse.
No.
Sec.
T.
R.

Nea County

County Doniphan Elev. _____

Sec. 19 Twp. 1 Rge. 24E

Company Gordon Curtis

Farm Name Geo. Reder No. 1

TOPS	DEPTH	LOG	DATUM	Loc. in Sec.																
Anh.				NW NE SE																
Tp.																				
H.																				
Tr.																				
Dg.																				
Bl.																				
L.				Geol. _____																
K.C.				Contr. _____																
B.K.C.																				
Ce.				<u>Nomaha</u>																
C.				Pool _____																
M.																				
M.				<u>Wildcat</u>																
K.				<table border="1"> <tr> <td></td> <td></td> <td></td> <td></td> </tr> </table>																
Mz.																				
Mq.																				
V.																				
S.																				
S.																				
A																				
R.																				
Pe.																				
G.																				
T.D.																				

FIRST REPORT
OCT 5 55

Date Comm. _____

RUR

Co.

Lse.

No.

Sec.

T.

R.