


Section 20 Township 4 Range 2E

Well No. #1 Strat

Company Phillips

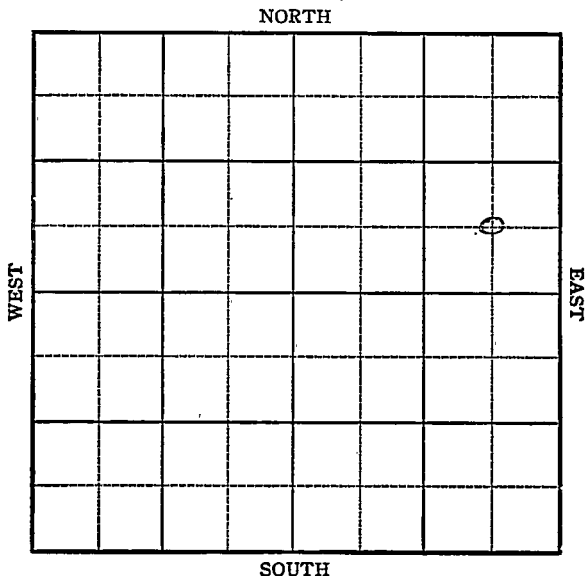


8

Sec. 20 Twp. 4 R. 2-E

Well No. #1 Strat Farm
Phillips Company

NORTH

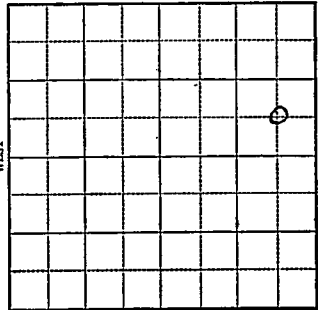

_____ Ft. from N. Line

660 Ft. from S. Line

660 Ft. from E. Line

_____ Ft. from W. Line

1944

E/ 1298

REPORT

2/9

- Lans 1730
- BKC 1880
- Miss 2243
- Lind 2249
- Devonian 2268
- Sy 2587
- Cherty Viola 2656
- Decorah 2749
- St. Peter Sand 2958
- Arb 2997
- TD 3027'
- D&A

$$\begin{array}{r} 2243 \\ 1730 \\ \hline 513 \end{array}$$

$$\begin{array}{r} 2268 \\ 2243 \\ \hline 25 \end{array}$$

$$\begin{array}{r} 2243 \\ 1880 \\ \hline 363 \end{array}$$

$$\begin{array}{r} 2958 \\ 2268 \\ \hline 690 \end{array}$$

FIRST REPORT

J

ABANDONED

$$\begin{array}{r} 2958 \\ 1398 \\ \hline -1560 \end{array}$$

$$\begin{array}{r} 2243 \\ 1398 \\ \hline 845 \end{array}$$

$$\begin{array}{r} 1880 \\ 1398 \\ \hline 492 \end{array}$$

$$\begin{array}{r} 1730 \\ 1398 \\ \hline 332 \end{array}$$

KANSAS

Map No. 176 Sec. 20 Twp. 4 R. 2E

Well No. 1 Strat

Phillips Company

FIRST REPORT
ABANDONED Contractor

C SE NE

SECTION PLAT

 Ft. from N. Line
660 Ft. from S. Line
660 Ft. from E. Line
 Ft. from W. Line

<u>E1, 1378</u>			<u>1</u>
			<u>0</u>

Wildcat

Location

Rig up

Drilling and Remarks:

Lans. 1730
B KC 1880
Miss. 2243
Kind. 2249
Devonian 2258
Sy 2587
Cherty Viola 2656
Viola 2729

RECORD

Cased in., ft.
Sand
Gas
Oil
Total Depth 8027

PRODUCTION

1st 24 hrs. Nat.
1st 24 hrs. after shot
Gas Cu. Ft.
Dry Hole
Abandoned

Decorah 2749 St. Peter Sand 2958
Date Arb. 2997 TD 3027 D & A
FEB 9 1944 19 S. J. LEWIS Scout