

15117000230000

FORM 51 25M 3-49 PETROL

Marshall


KANSAS

Section 21 Township 4 Range 7EWell No. #1 BrownCompany Geo. F. Johnston et al

NORTH

WEST

EAST

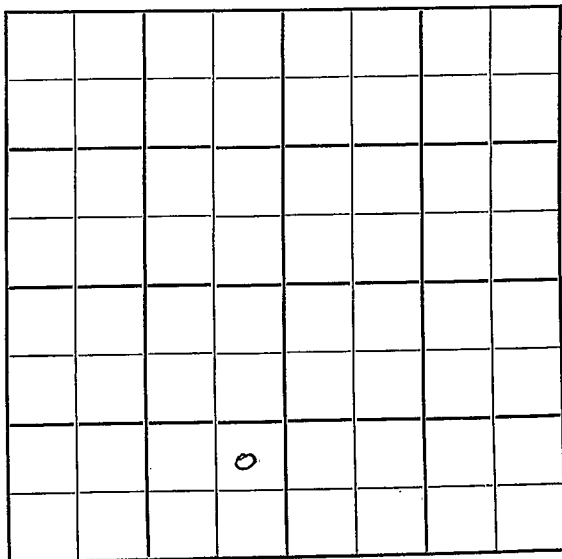

SOUTH

14

Marshall

KANSAS

Sec. 21 Twp. 4 R. 7E ✓

Well No. #1. Brown Farm

Geo. F. Johnston et al Company

Murfin Drlg. -Contr. Contractor


Wildcat

 Ft. from N. Line

990' Ft. from S. Line

330' Ft. from E. Line

 Ft. from W. Line

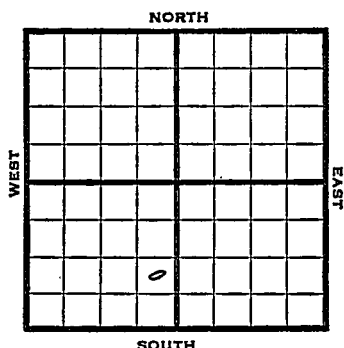

NE SE SW

1950

Elev. 1132' REPORT

10/25
11/8

RUR
Spud 10-27-50
D&A TD 2063'
8" @ 105' Howard 609'
Top 647' Heeb. 829'
Lans. 864' BKC 1103'
Hunton 1266' Viola 1540'
Simp. 1888' St. Peter Sd 1948'
TD 2063' D&A

ABANDONED

$$\begin{array}{r} 1948 \\ 1266 \\ \hline 682 \end{array}$$

$$\begin{array}{r} 1266 \\ 609 \\ \hline 657 \checkmark \end{array}$$

$$\begin{array}{r} 1266 \\ 864 \\ \hline 402 \checkmark \end{array}$$

$$\begin{array}{r} 1266 \\ 1103 \\ \hline 163 \checkmark \end{array}$$


$$\begin{array}{r} 1266 \\ 1103 \\ \hline 163 \end{array}$$

$$\begin{array}{r} 1132 \\ 464 \\ \hline +268 \end{array}$$

$$\begin{array}{r} 1948 \\ 1132 \\ \hline -816 \end{array}$$

$$\begin{array}{r} 1266 \\ 864 \\ \hline 402 \end{array}$$

1103

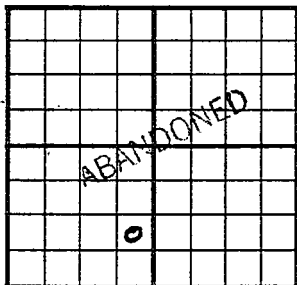County Marshall State KansasSec. 21 (Blk. Twp.) 4 (Sur. Rge.) 7E Map No.Operator Geo. F. Johnston et al.Well No. 1 Farm BrownElev. 1132 Location NE SE SW990 Ft. From S Line SW330 Ft. From E Line Quarter

1st. Report

Completion NOV 8 1950Remarks WildcatMurfin Drlg. - Contr.Spudding Date 10-27-50Drlg. Data D & A TD 20638" @ 105 Howard 609 Top. 647Heeb. 829 Lans. 864 B KC 1103Hunton 1266 Viola 1540 Simp. 1888St. Peter sand 1948 TD 2063D & A

1266

$$\begin{array}{r} 1266 \\ 1103 \\ \hline 163 \end{array}$$

J. E. TYRA